


T. 1 S. R. 3 E. W. M.

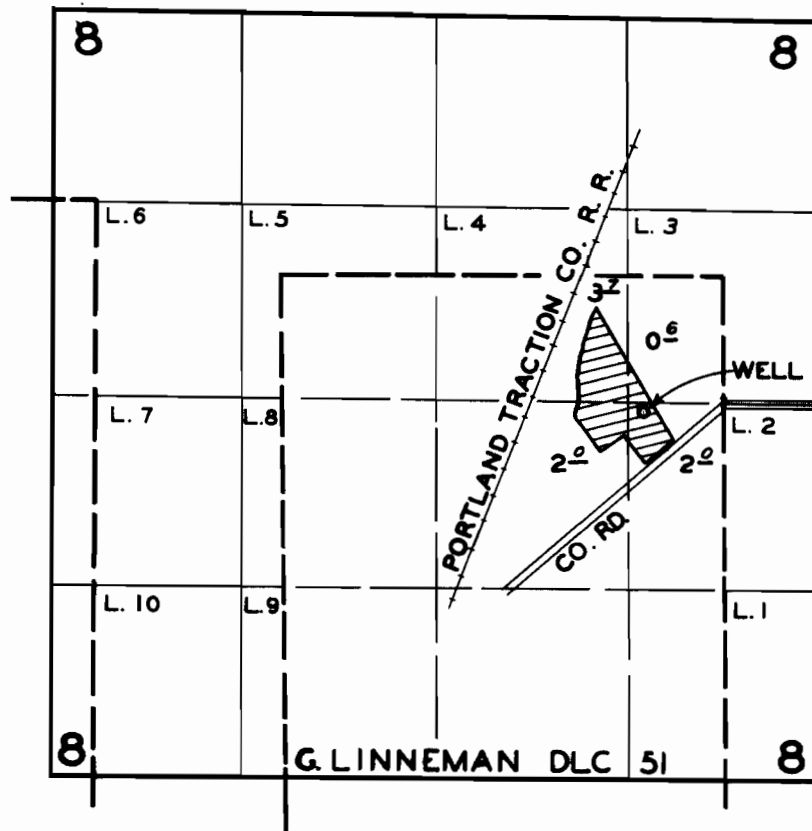

FINAL PROOF SURVEY
UNDER

Application No. G.1000 Permit No. G. 896.....
IN NAME OF

.....RAYMOND E. BECHTOLDT.....

Surveyed MAY 12 19.60, by C.O. BARTELS.....