


T. 1 N. R. 3 E. W. M.

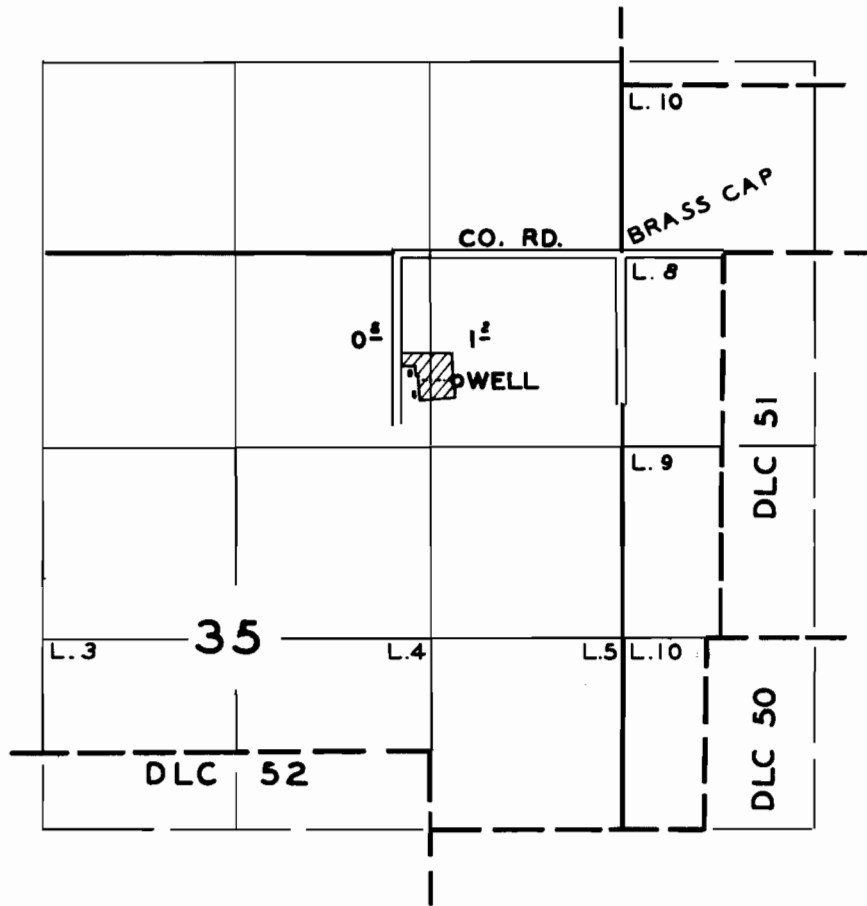

FINAL PROOF SURVEY UNDER

Application No. G.1161..... Permit No. G.1105.....
IN NAME OF

.....ERMA V. GOODMAN.....

Surveyed MAY 11..... 1960., by C.O. BARTELS.....