


T. IN. R. 3E. W.M.

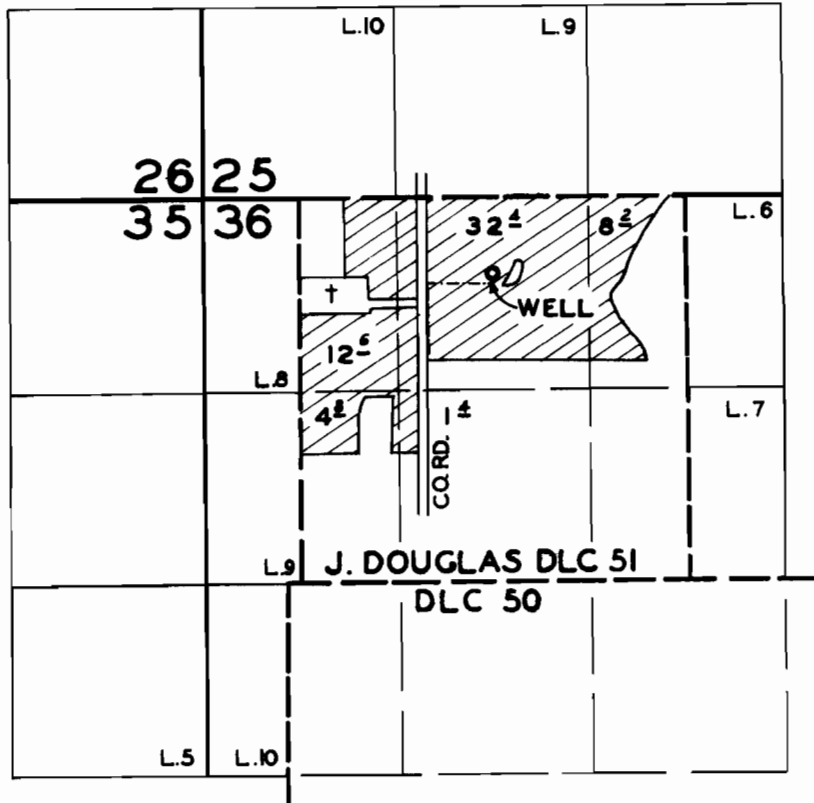

**FINAL PROOF SURVEY**  
UNDER

Application No. G1162..... Permit No. G1179.....  
IN NAME OF

.....FAYETTE L. WEEDIN.....

Surveyed MAY 11..... 19 60., by C. O. BARTELS.....