


T. 15. R. 4E. W.M.

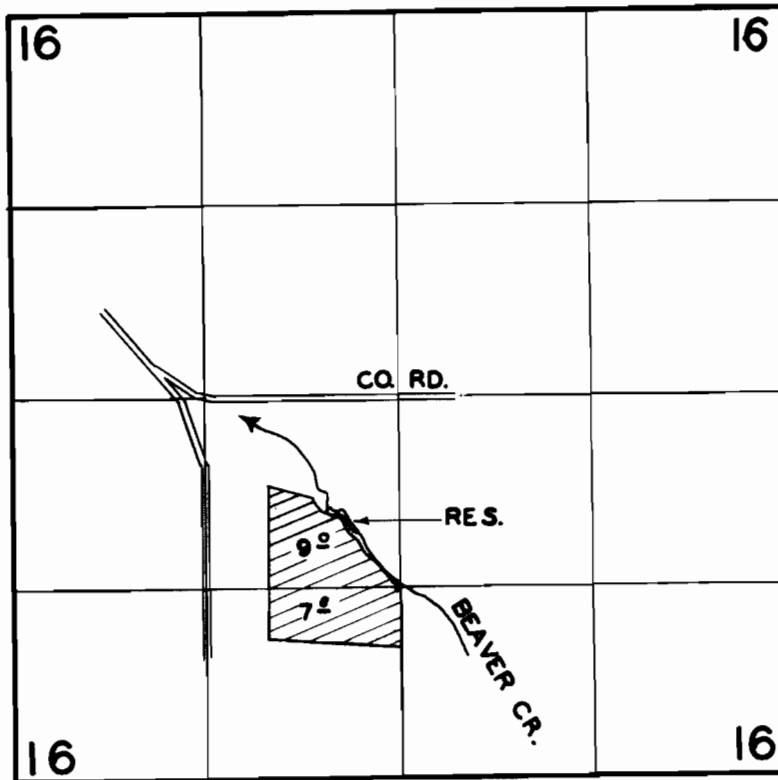

FINAL PROOF SURVEY UNDER

Application No. 28667 R.28787 Permit No. 22574 R.1562
IN NAME OF

FREDERICK JOHN & DORA LOUISE MORGAN

Surveyed MAY 9 1960, by G. O. BARTELS