


T. 1S. R. 4E. W.M.

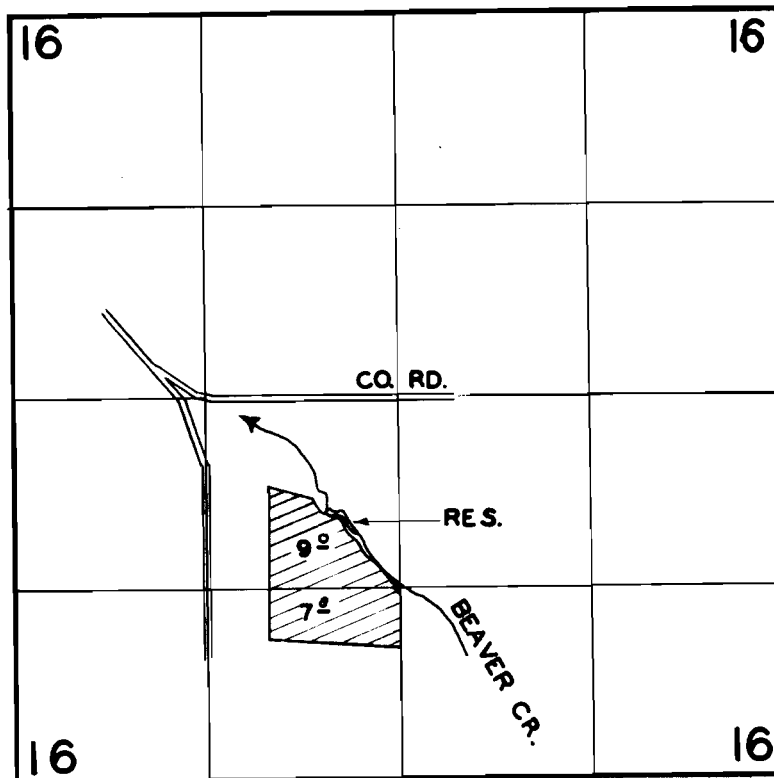

FINAL PROOF SURVEY
UNDER

Application No. ²⁸⁶⁶⁷ ~~R28787~~ Permit No. ²²⁵⁷⁴ ~~R1562~~
IN NAME OF

FREDERICK JOHN & DORA LOUISE MORGAN

Surveyed MAY 9 19.60, by C. O. BARTELS