


T. 1N. R. 5E. W.M.

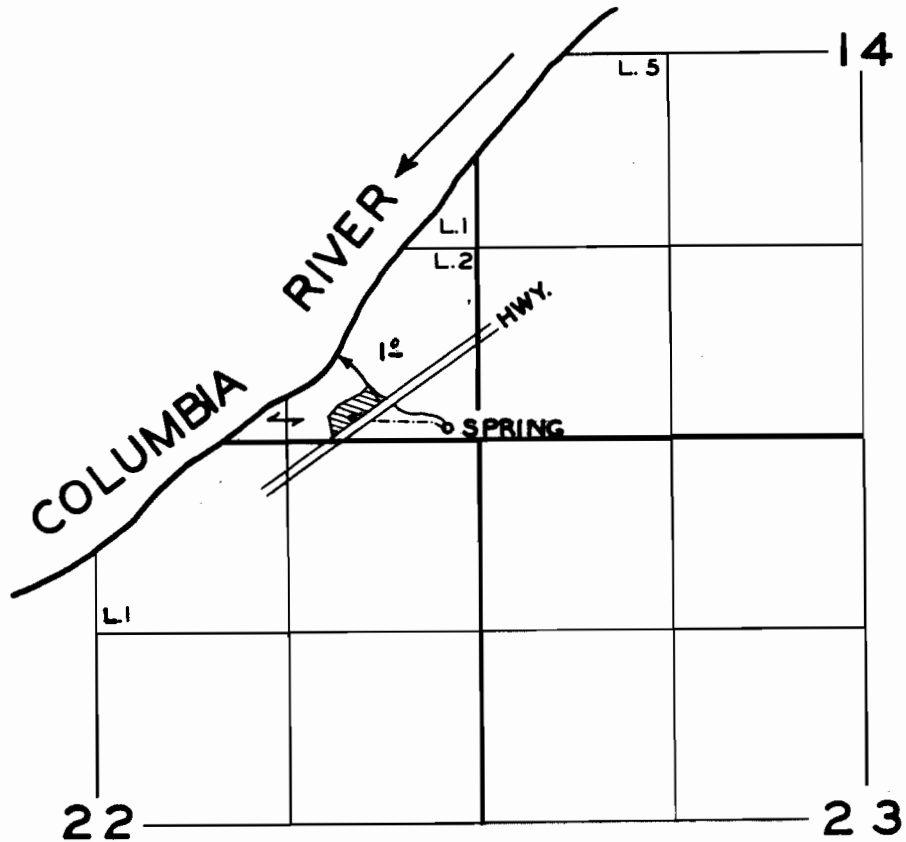

**FINAL PROOF SURVEY**  
UNDER

Application No. 28811..... Permit No. 22676.....  
IN NAME OF

.....JARVIS KILNESS.....

Surveyed MAY 11, 1960., by C. O. BARTELS.....