


T. IS. R. I. E. W.M.

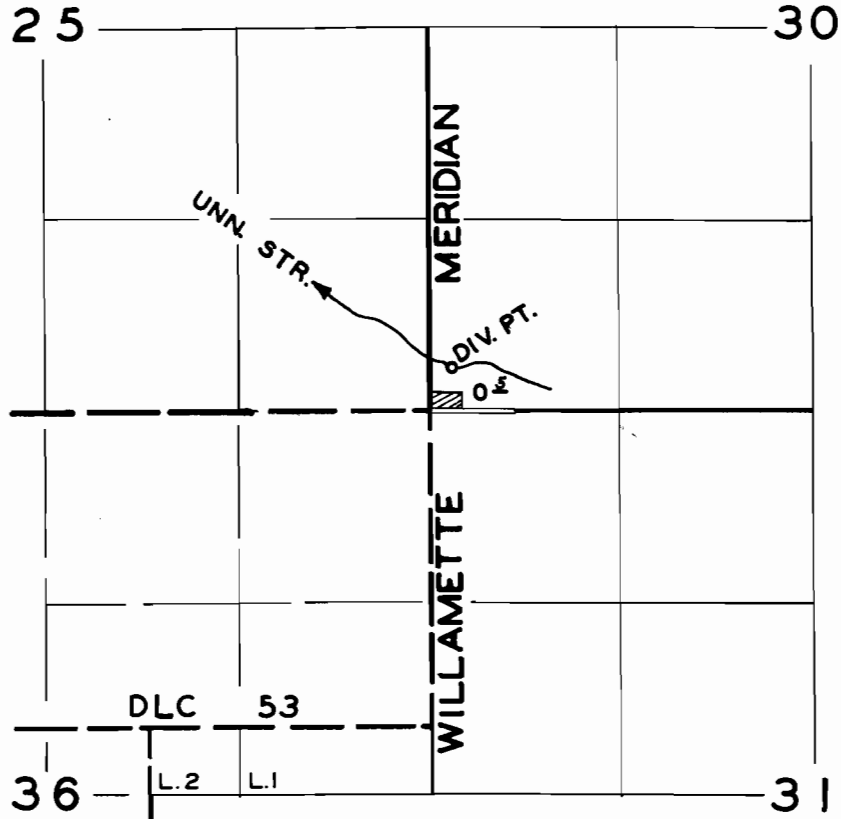

FINAL PROOF SURVEY
UNDER

Application No. 30642 Permit No. 24170
IN NAME OF

WILLIAM D. & JOANNE YAGER

Surveyed JULY 5, 1960, by C. O. BARTELS