


T.6S. R.4W.W.M.

24

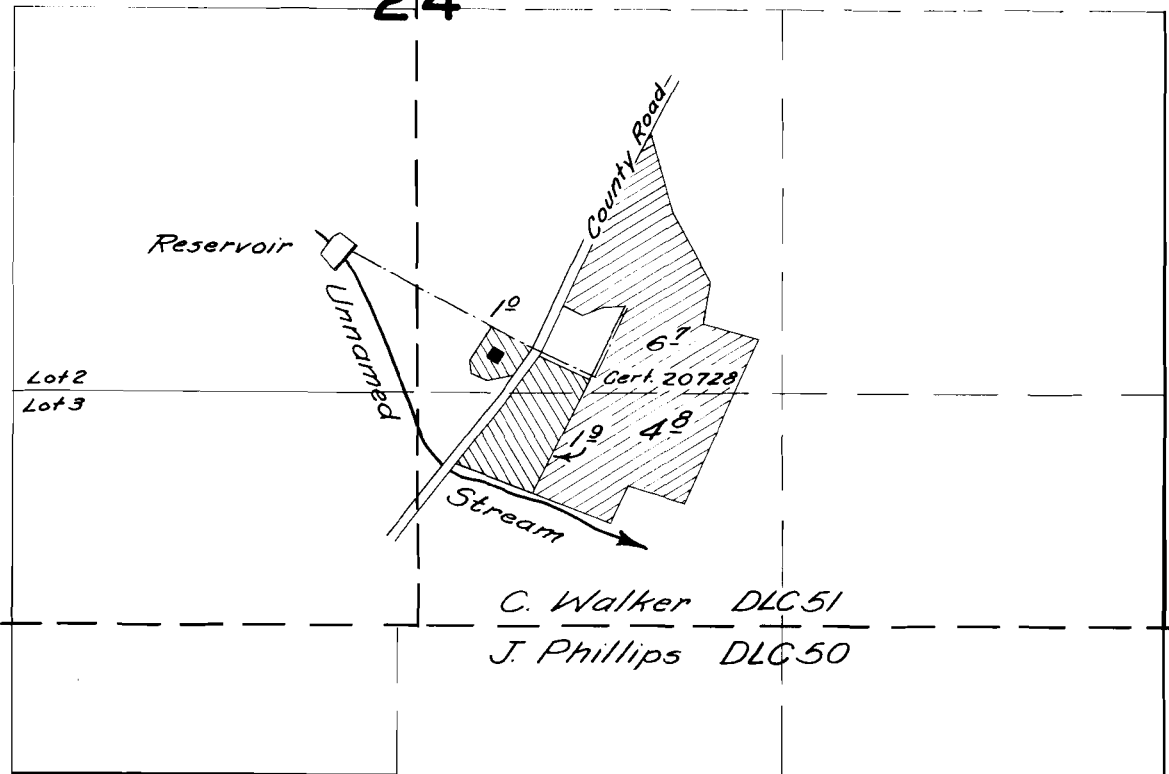

Scale: 1" = 660

FINAL PROOF SURVEY
UNDER

Application No. ~~30830~~ ^{R-30829} Permit No. ~~24268~~ ^{R-1875}
IN NAME OF

BYRON J. PURVINE

Surveyed June 21, 1960, by C.O. Bartels