


T.6S.R.4-5W.W.M.

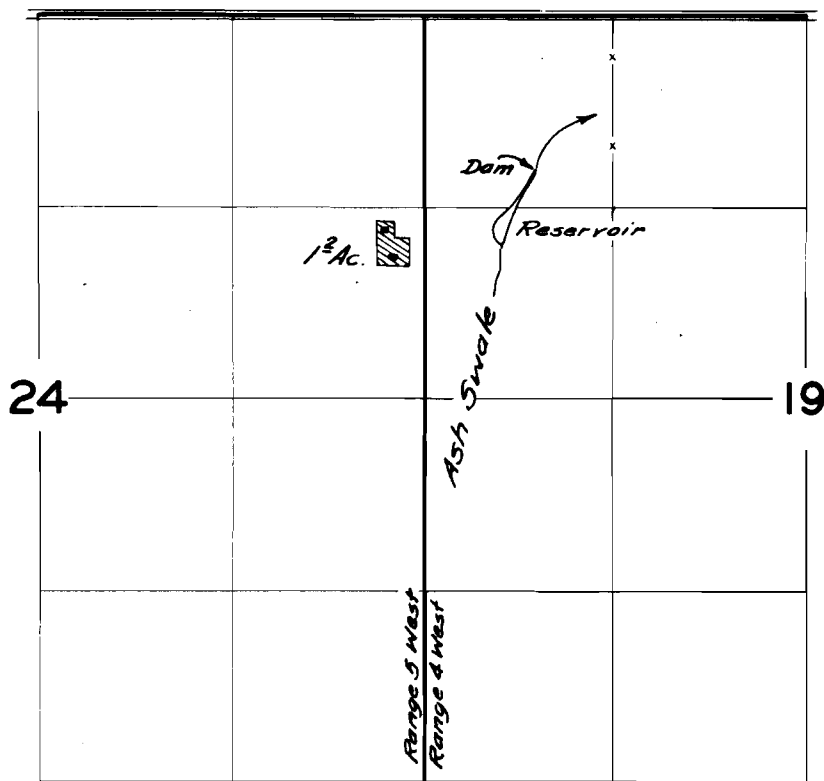

FINAL PROOF SURVEY UNDER

Application No. *R-31602* / *31603* Permit No. *R-2038* / *24970*
IN NAME OF

E. J. Scharf

Surveyed *June 21* 1960, by *C. O. Bartels*