


West Rv. Map.

18 T.P. 39 R. 11 1/2 S W.M.

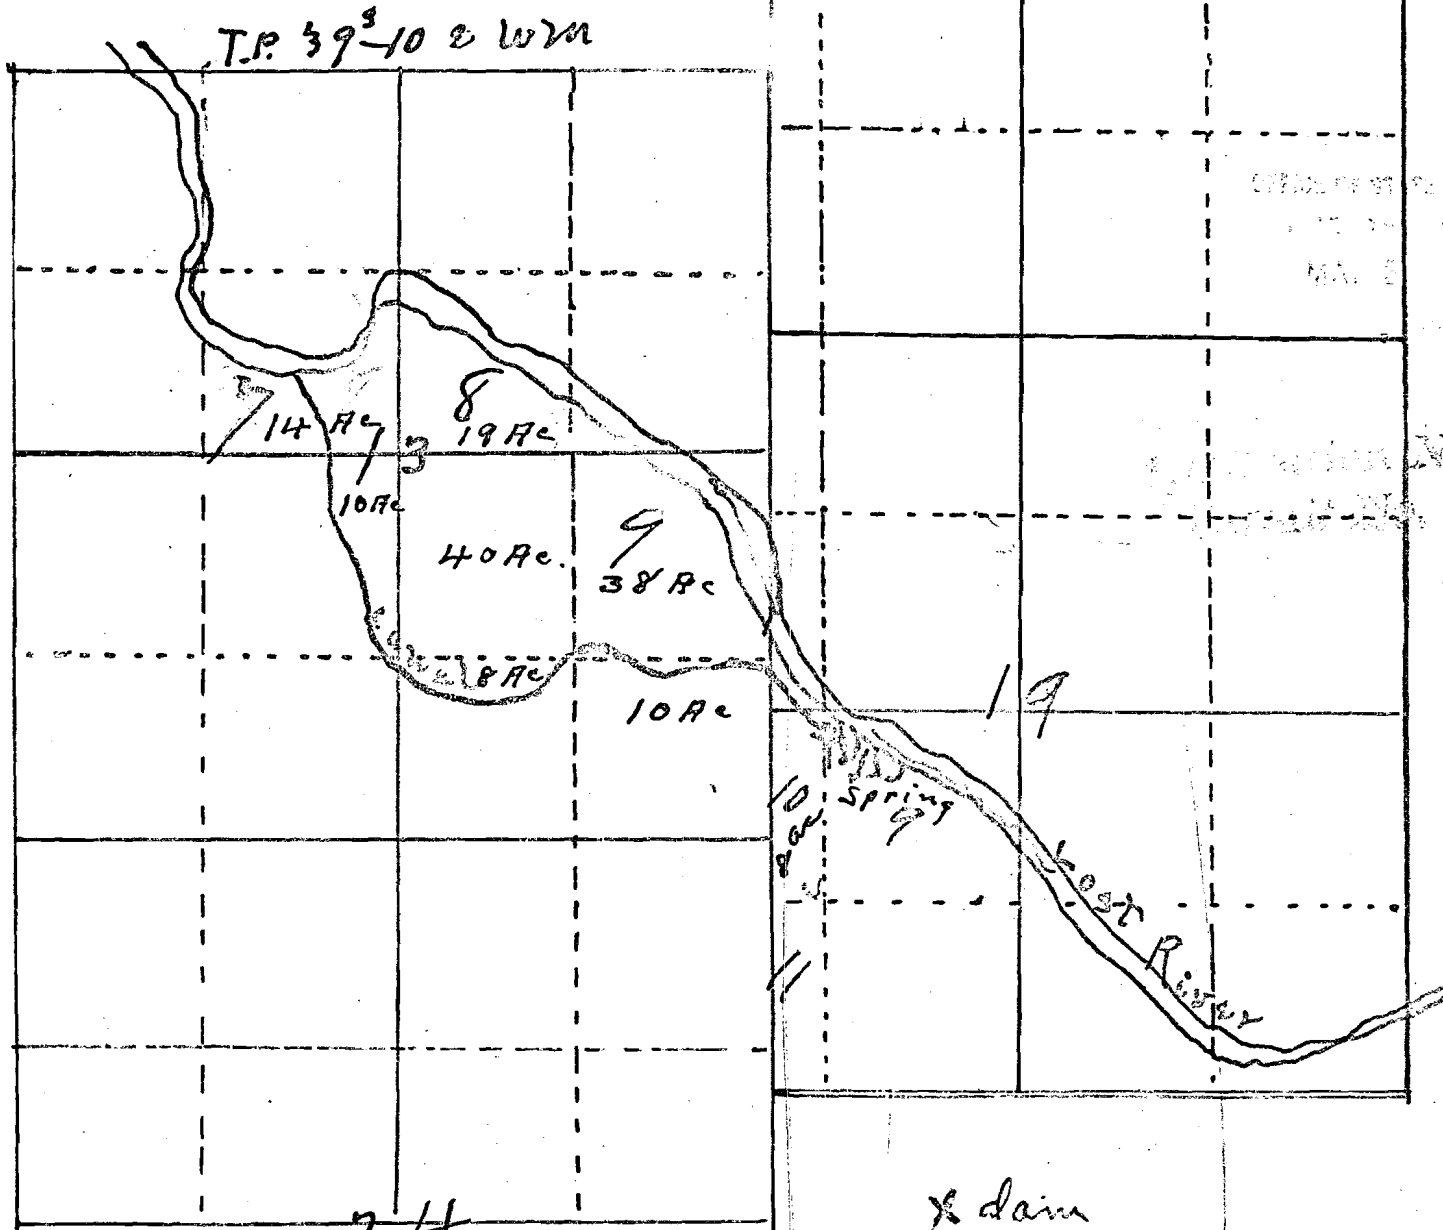

2726
1618

24

x dam
Spring

1618
2827