


T.7S.R.4W.W.M.

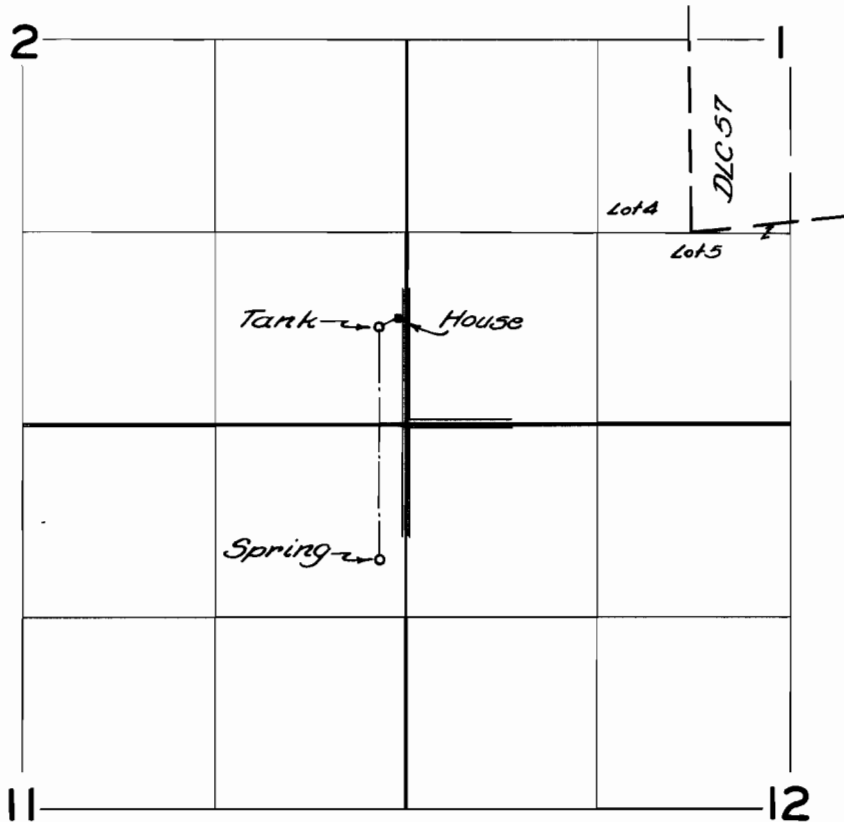

FINAL PROOF SURVEY UNDER

Application No. 33200... Permit No. 26252...
IN NAME OF

Wilford H. or Florence N. Slinker

Surveyed July 8... 1960, by C.D. Bartala