


# T. 5 & 6 N. R. 34 & 35 E. W.M.

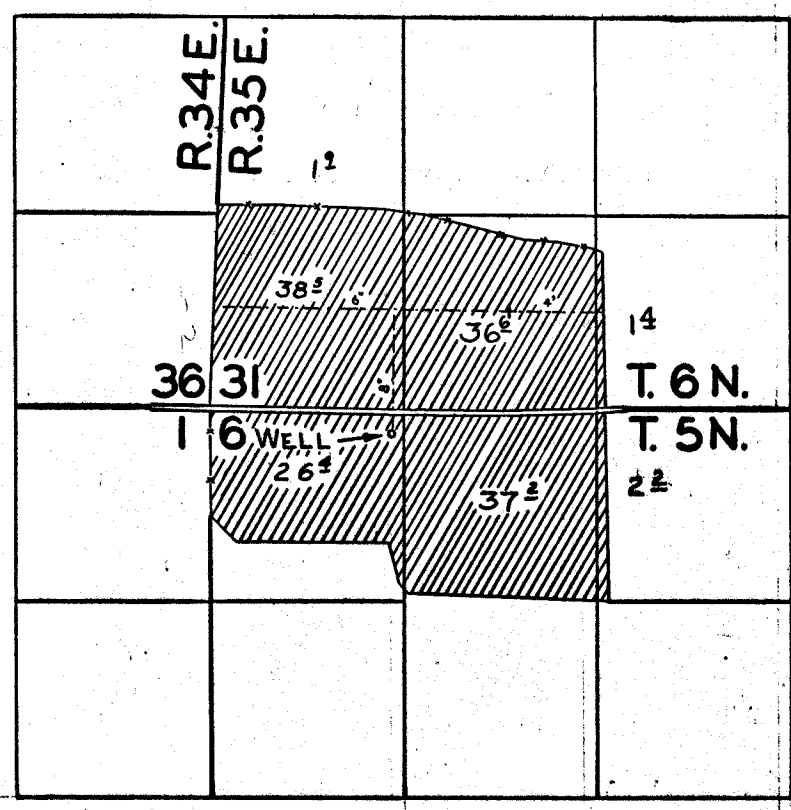

## FINAL PROOF SURVEY UNDER

Application No. G. 55..... Permit No. G. 154.....  
IN NAME OF

..... ERNEST KEY .....

Surveyed JULY 14, 1960, by M. BISH.....