


T. 4N. R. 35E.W.M.

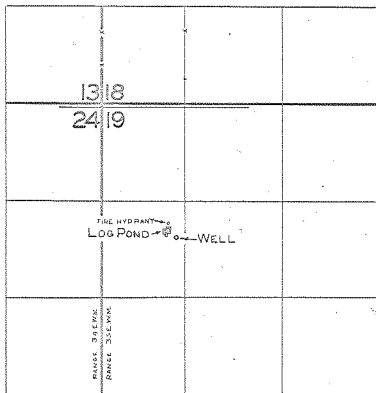

FINAL PROOF SURVEY
UNDER

Application No. G-419..... Permit No. G-289.....
IN NAME OF

.....THE ATHENA MILL Co.....

Surveyed JULY 21, 1960, by M. BISH.....