


T.6N. R.33E.W.M.

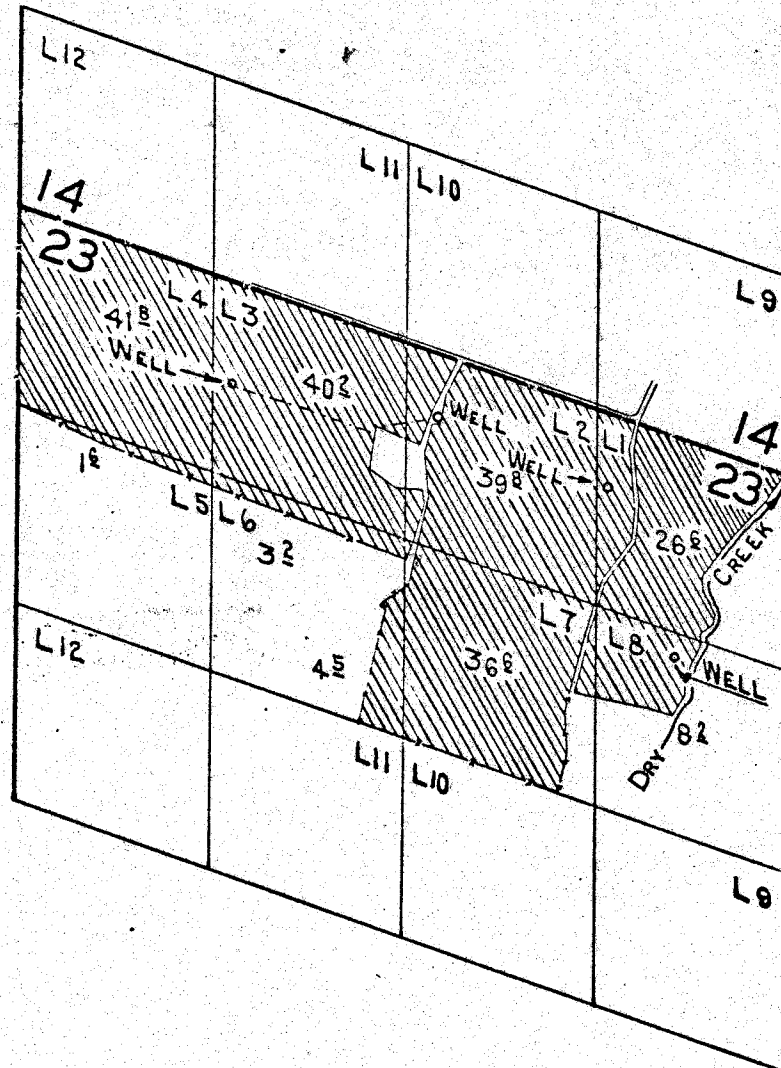

FINAL PROOF SURVEY
UNDER

Application No. G-426 Permit No. G-421
IN NAME OF

ARCHIE HARRIS

Surveyed JULY 19 1960, by M. BISH