


T6N.R.35 E.W.M.

G-1370

28274

OREGON-WASHINGTON STATE LINE

Appl. G-1494
Rev. G-1370

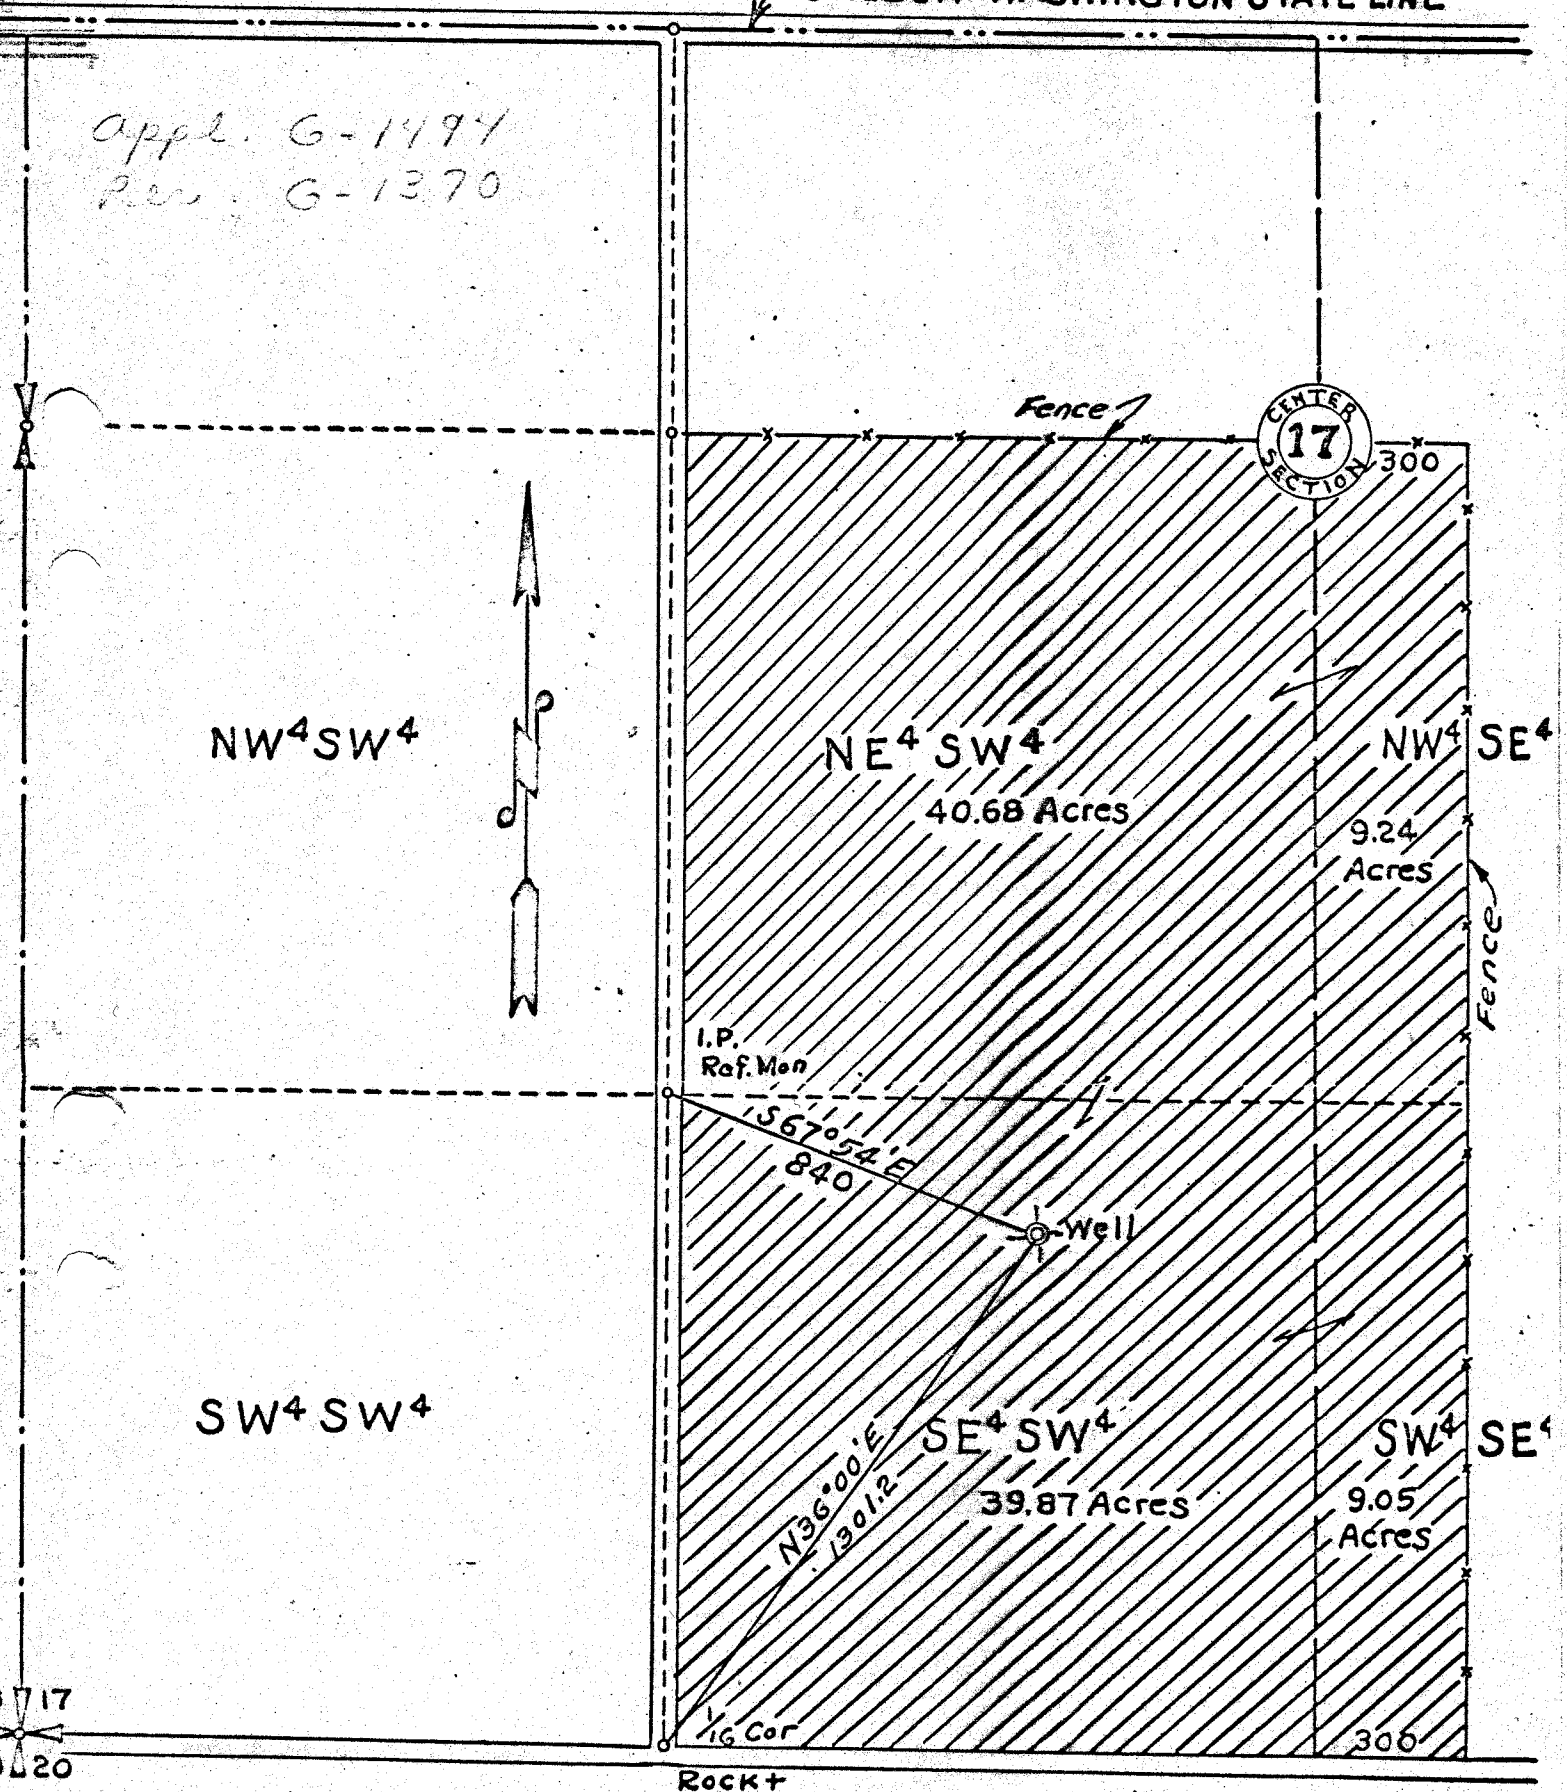

I, Clinton W. Cote of Walla Walla, Washington, do hereby certify that this Map was made from notes taken during