


T. I. S. R. I. W. W. M.

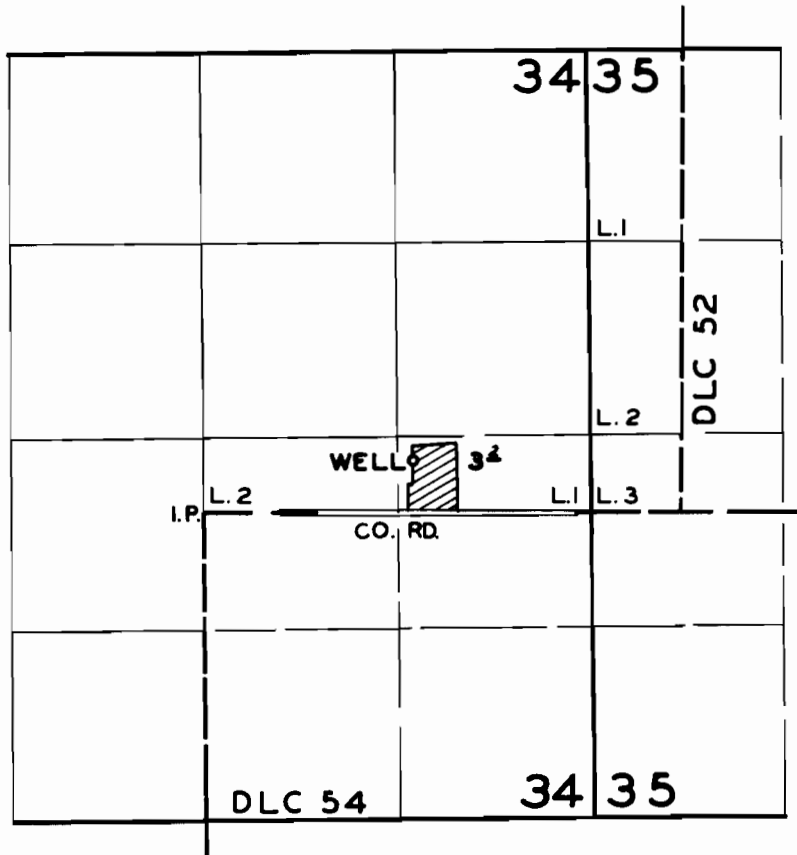

**FINAL PROOF SURVEY**  
UNDER

Application No. G1189..... Permit No. G1058.....  
IN NAME OF

.....CECIL K. CARNAHAN.....

Surveyed JULY 7, 1960, by G. O. BARTELS.....