


T. 2S. R. 2 W.W.M.

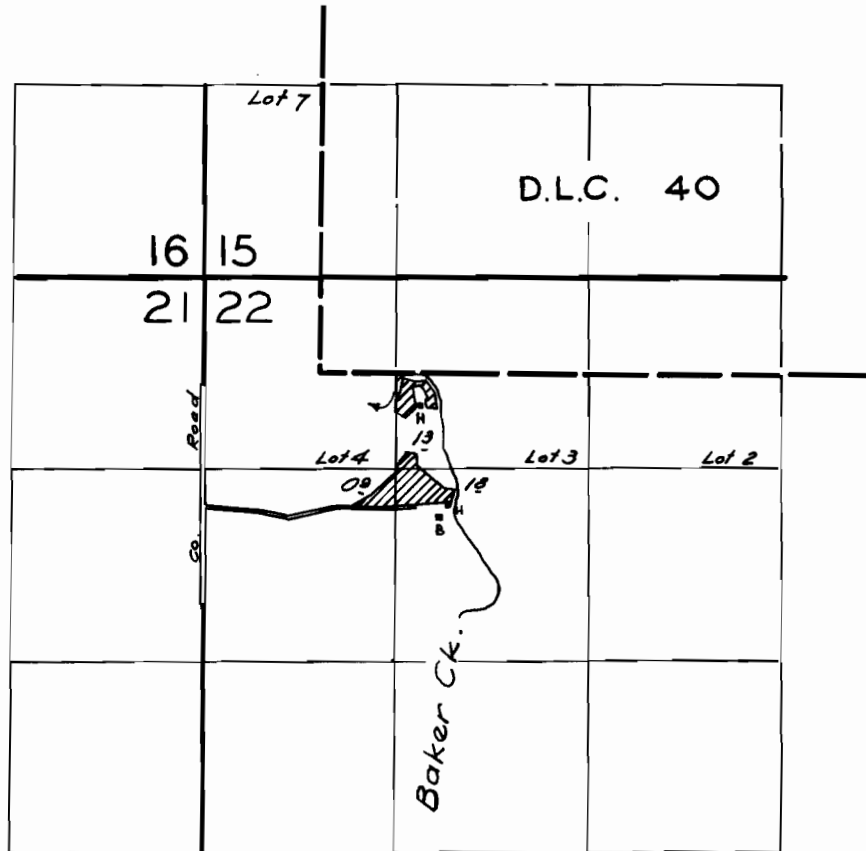

FINAL PROOF SURVEY
UNDER

Application No. 26628 Permit No. 20852
IN NAME OF

S.A. Gotter

Surveyed July 7, 1960, by *R.H. Jackson*