


T.2 N. R. 3 W.W.M.

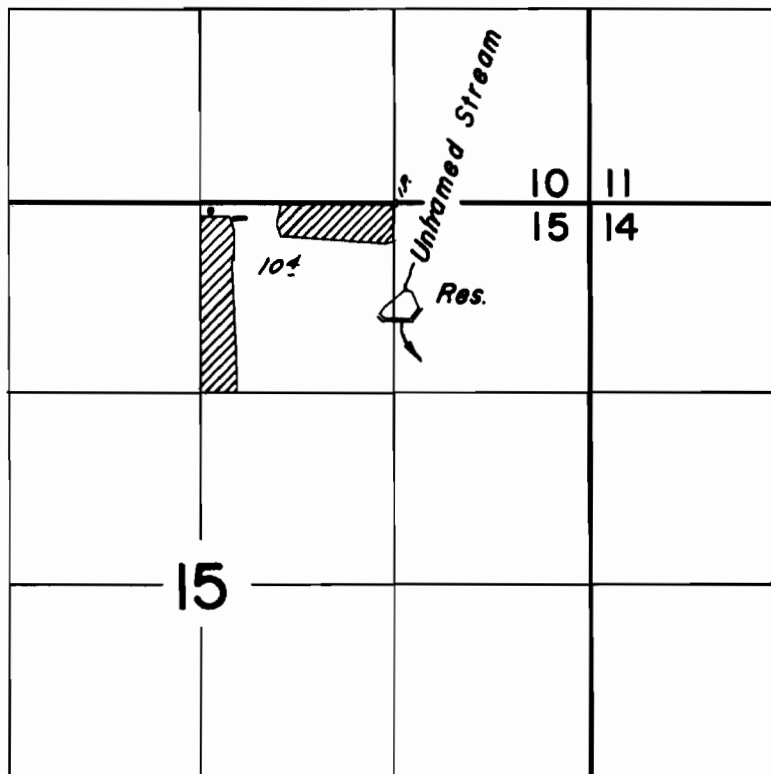

**FINAL PROOF SURVEY**  
UNDER

Application No. R-29436 29437 Permit No. R-1672 23175  
IN NAME OF

Walter H. & Bessie L. Welch

Surveyed June 5, 1959, by *Johnson*