


# T. 4 & 5 S. R. 3 & 4 W.W.M.

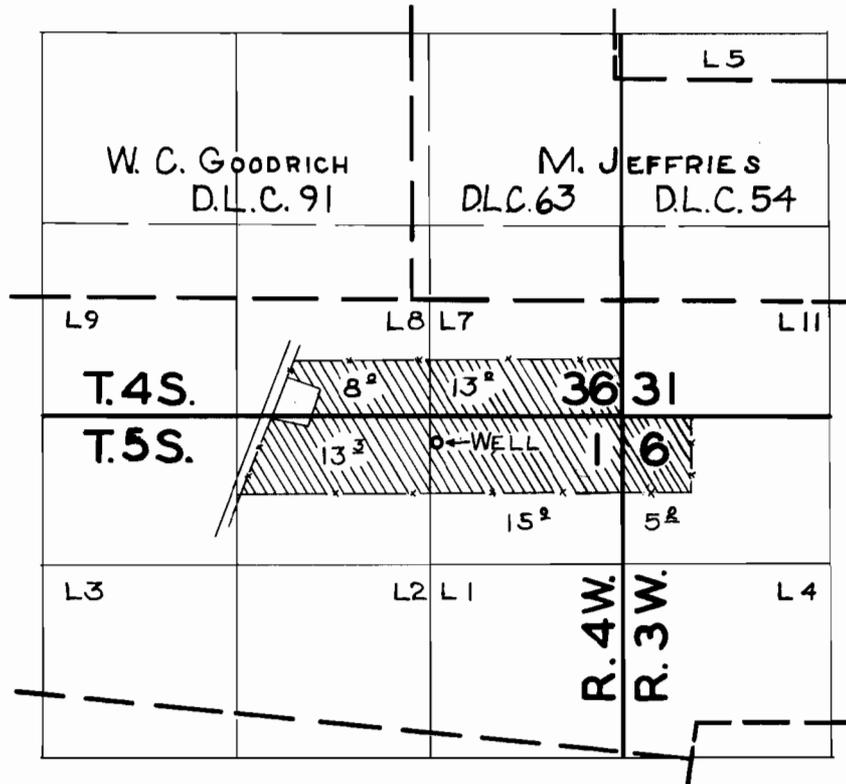

## FINAL PROOF SURVEY UNDER

Application No. G. 243 Permit No. G. 149  
IN NAME OF

EARLE F. & LAVERNE E. DAY

Surveyed MAY 16 1960, by M. BISH