T.4 S.R.3 & 4 W.W.M.

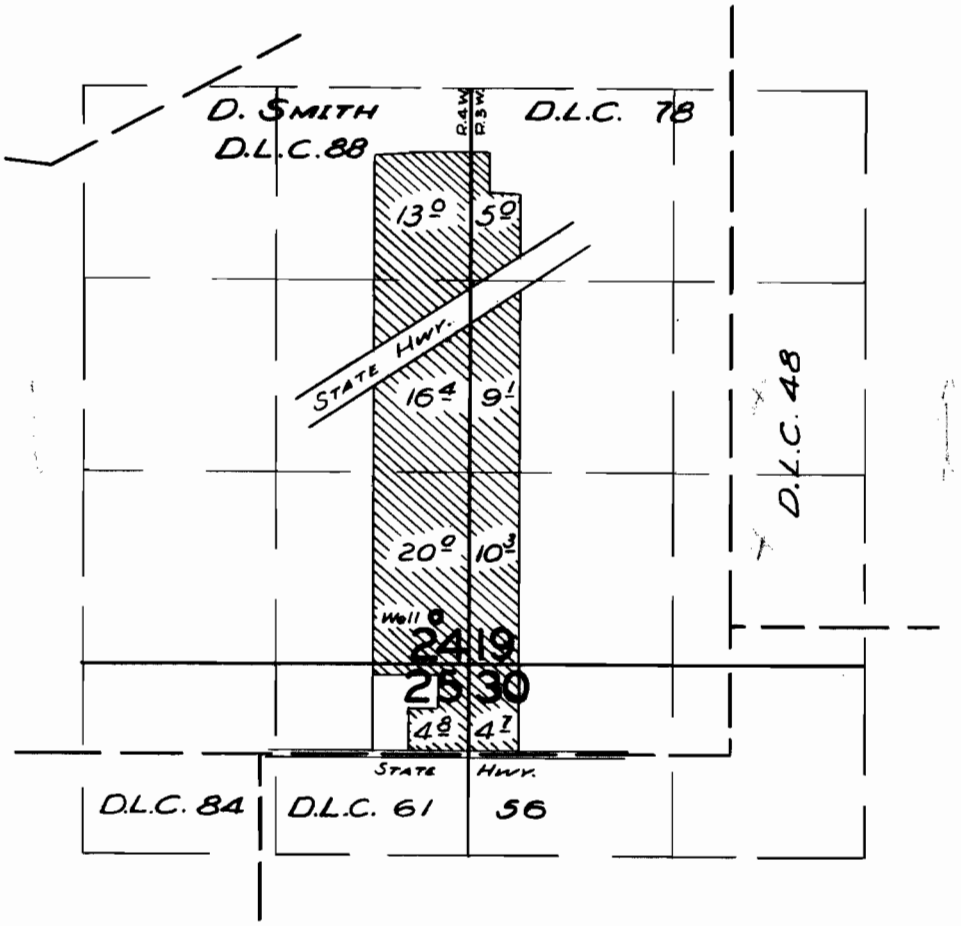

FINAL PROOF SURVEY
UNDER

Application No. G-622 Permit No. G-536
IN NAME OF

ROSS & MARY LEE CRUICKSHANK

Surveyed 24 MAY 1960, by Fm. Bish

DFQ-3D-164