


T.3 S.R.3 W.W.M.

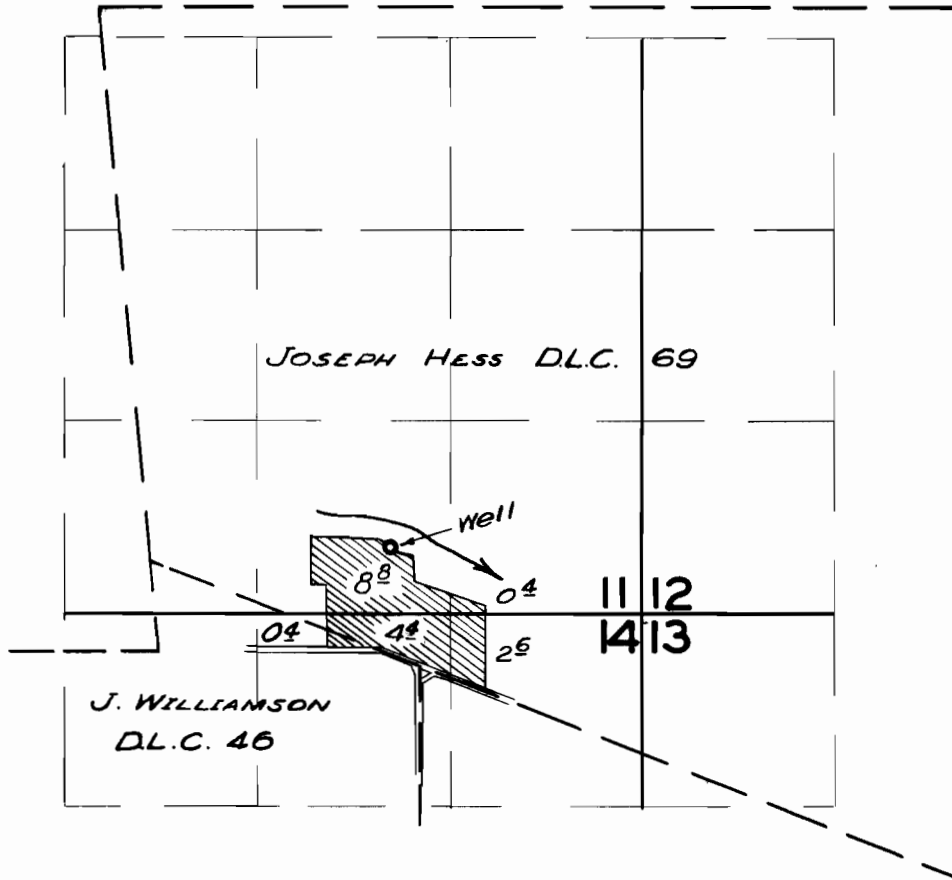

FINAL PROOF SURVEY UNDER

Application No. G-1313 Permit No. G-1172
IN NAME OF

RAY A. THOMAS

Surveyed 26 MAY 1960, by Tom B. Bish