


T.3S.R.2W.W.M.

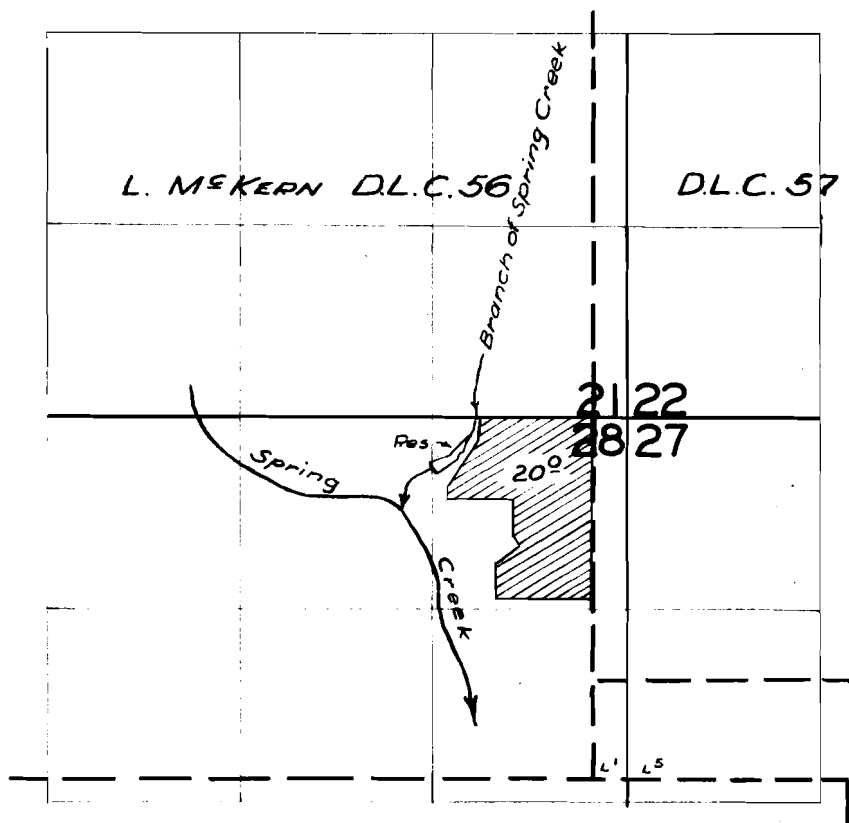

FINAL PROOF SURVEY UNDER

D 26650 R-1281
Application No. 26723 Permit No. 20914
IN NAME OF
ESTATE OF
CLIFFORD W. JONES

Surveyed 26 MAY 1960, by M. Bish