


T.5 S.R.4 W.W.M.

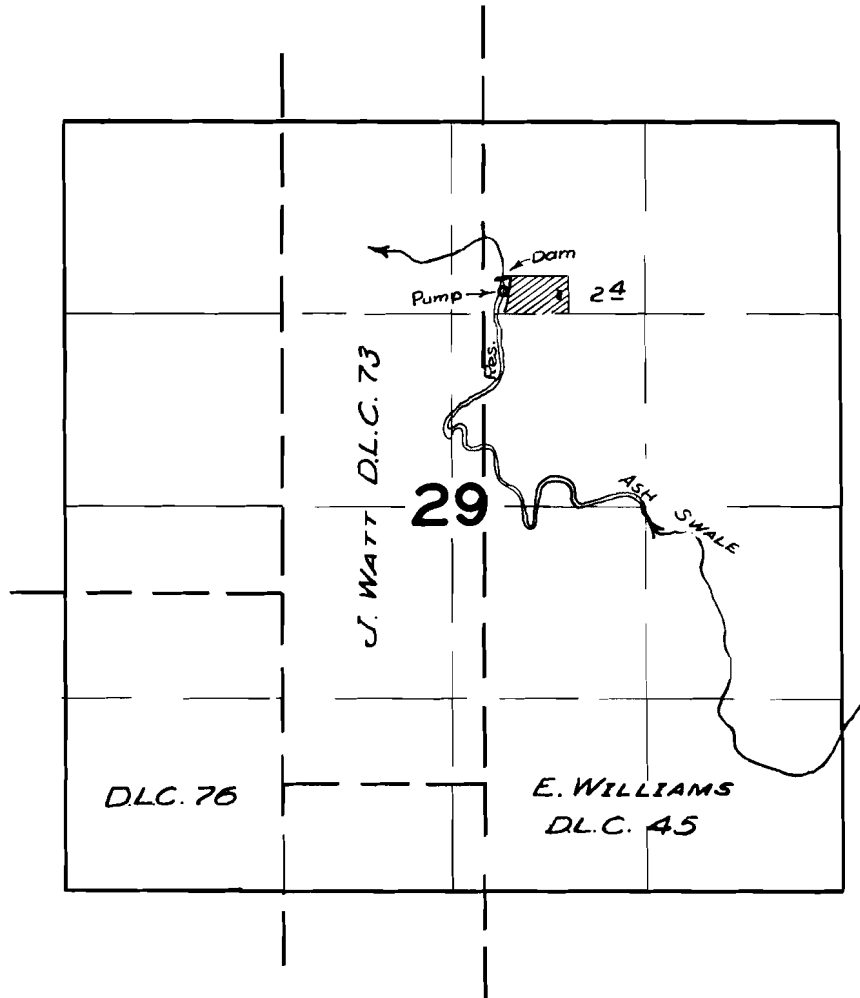

FINAL PROOF SURVEY UNDER

Application No. ^{R-29842} ~~29843~~ Permit No. ^{R-1724} ~~23468~~
IN NAME OF

..... A. A. ANDERSON

Surveyed 18 May 1960, by Tom Bish.....