


# T.5 S.R.4 W.W.M.

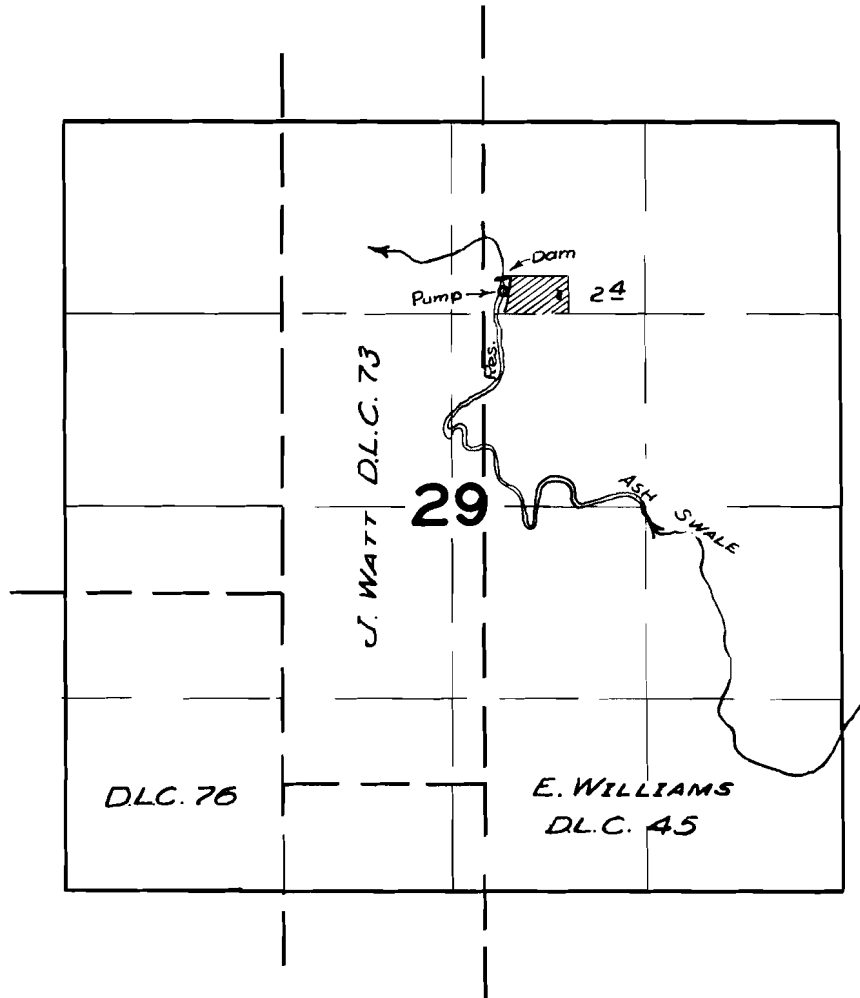

## FINAL PROOF SURVEY UNDER

Application No. <sup>R-29842</sup> ~~29843~~ Permit No. <sup>R-1724</sup> ~~23468~~  
IN NAME OF

A. A. ANDERSON

Surveyed 18 May 1960, by Tom Bish