


T.5 S.R.3 W.W.M.

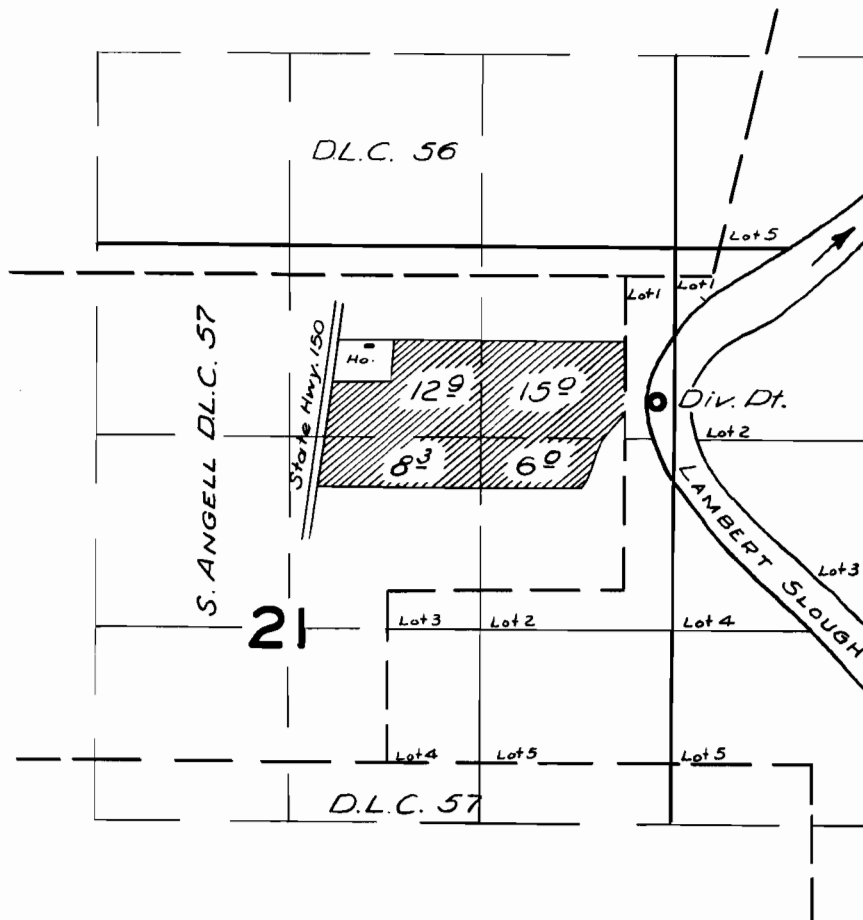

FINAL PROOF SURVEY UNDER

Application No. 30634 Permit No. 24168
IN NAME OF

RALPH D. STOUTENBURG

Surveyed JUNE 1960, by Mc Bish