


T.5 S.R.6 W.W.M.

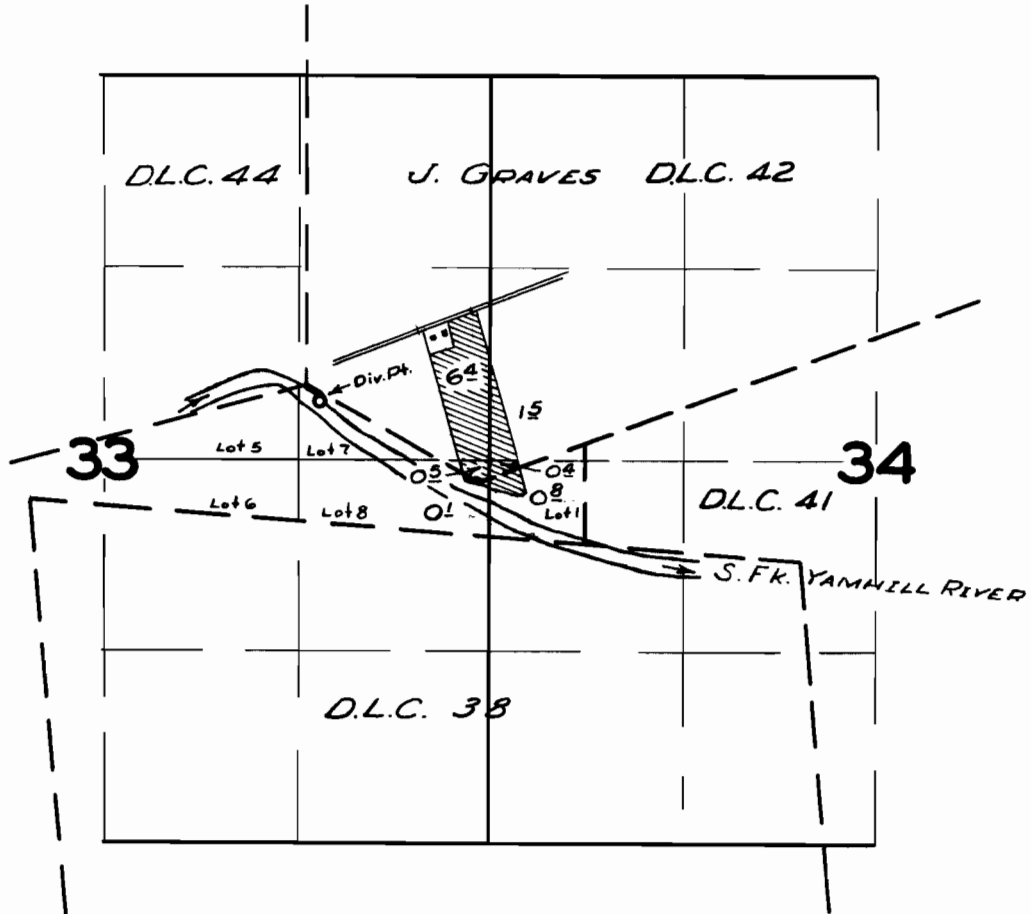

FINAL PROOF SURVEY
UNDER

Application No. 31993 Permit No. 25245
IN NAME OF

HARLOW H. BAKER

Surveyed 19 MAY 1960, by Ma. Bish