


T.3 S.R.2W.W.M.

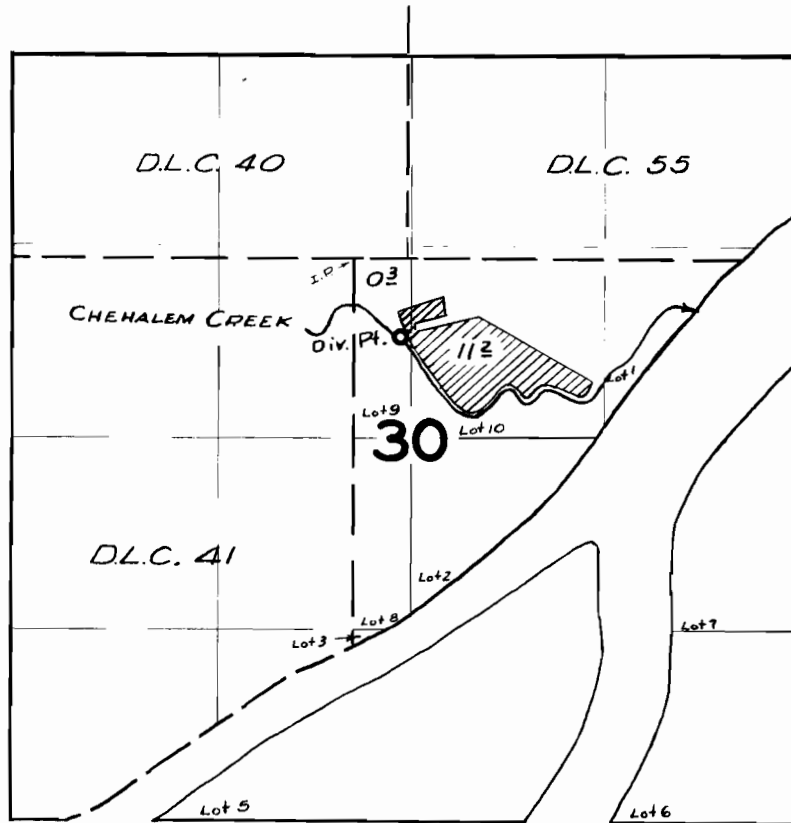

FINAL PROOF SURVEY UNDER

Application No. 32400 Permit No. 25583
IN NAME OF

RUTH M. MELLINGER

Surveyed 31 MAY 1960, by Tom Bish