


T.4 S.R.5 W.W.M.

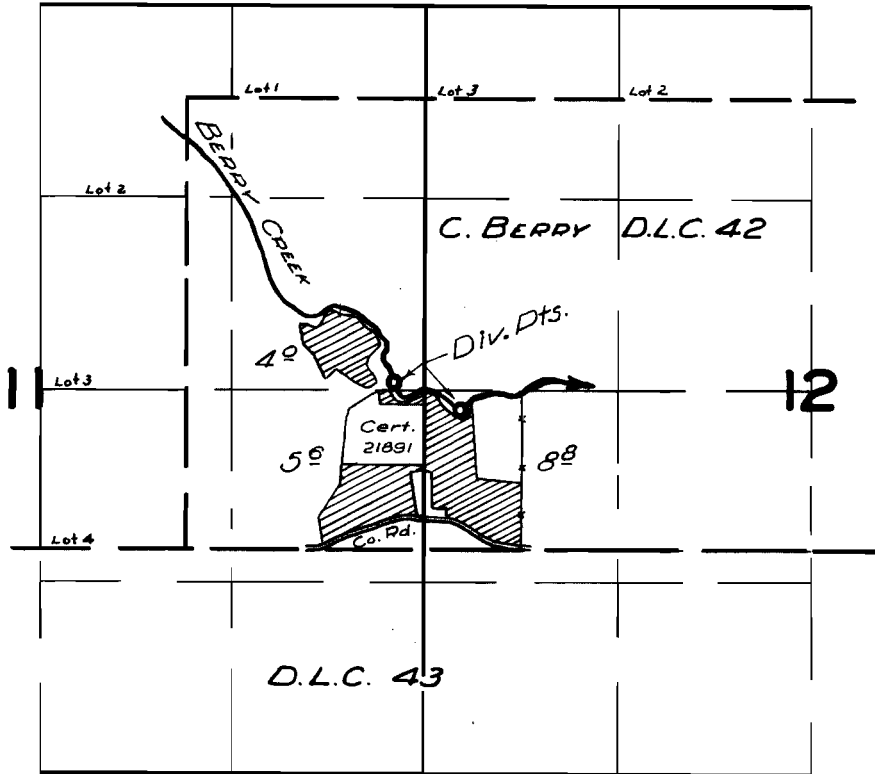

**FINAL PROOF SURVEY**  
UNDER

Application No. 26855 Permit No. 25986  
IN NAME OF

FRED SMALLEY

Surveyed JUNE 1960 by M. Besh