


T.11S. R.46E. W.M.

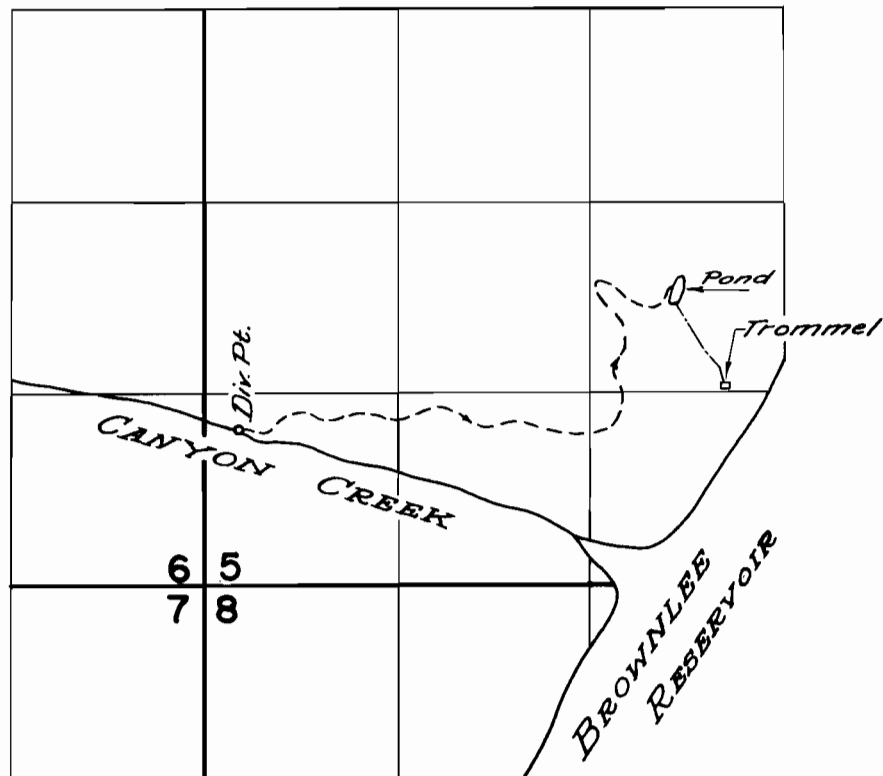

FINAL PROOF SURVEY
UNDER

Application No. 32582 Permit No. 25927
IN NAME OF

ERNEST C. SNYDER

Surveyed Sept. 13 1960, by C. O. Bault