


T.5S.R.1E.W.M.

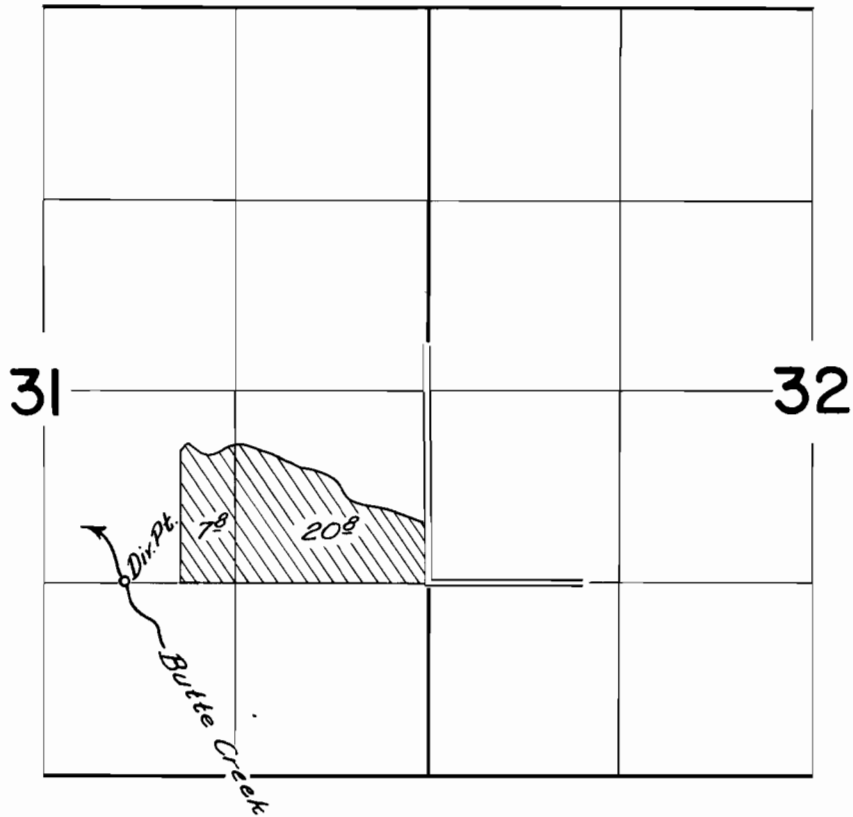

**FINAL PROOF SURVEY**  
UNDER

Application No. *25769* Permit No. *20521*  
IN NAME OF

*VINCENT M. BEYER*

Surveyed *Sept. 9* 1960, by *C.O. Baultz*