


T.2S. R.3E.W.M.

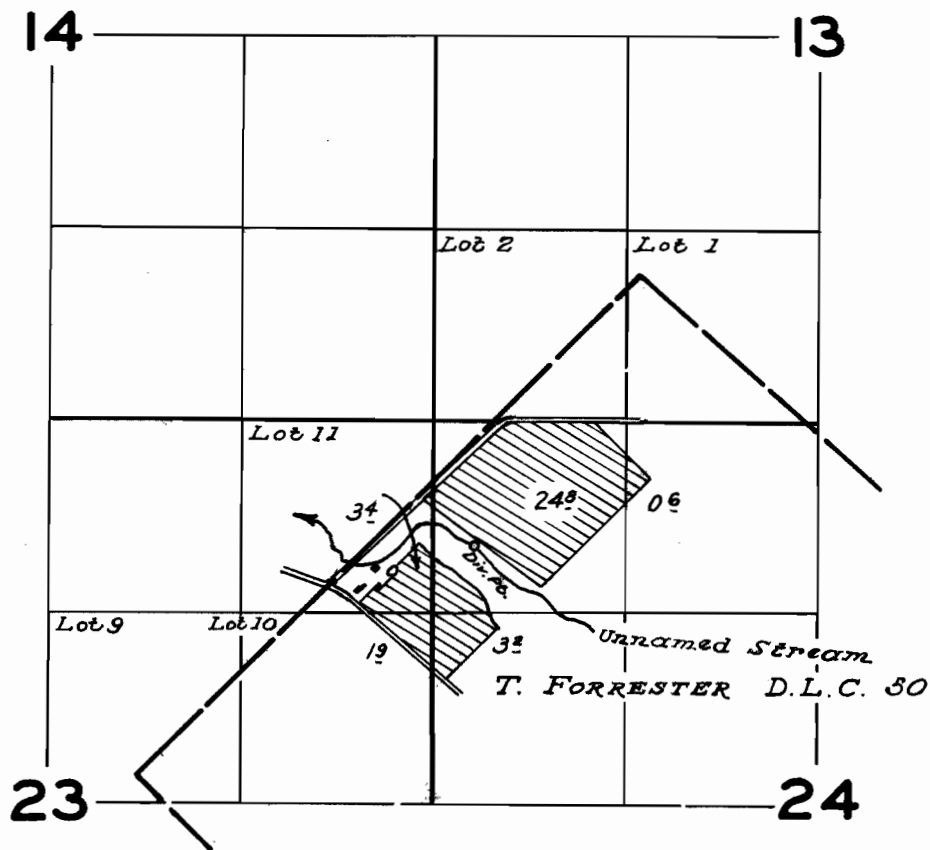

FINAL PROOF SURVEY
UNDER

Application No. 30841... Permit No. 24321...
IN NAME OF

OLIVER H. BURNS

Surveyed April 28 1960, by R. Jackson