


T. 8 N. R. 6 W. W. M.

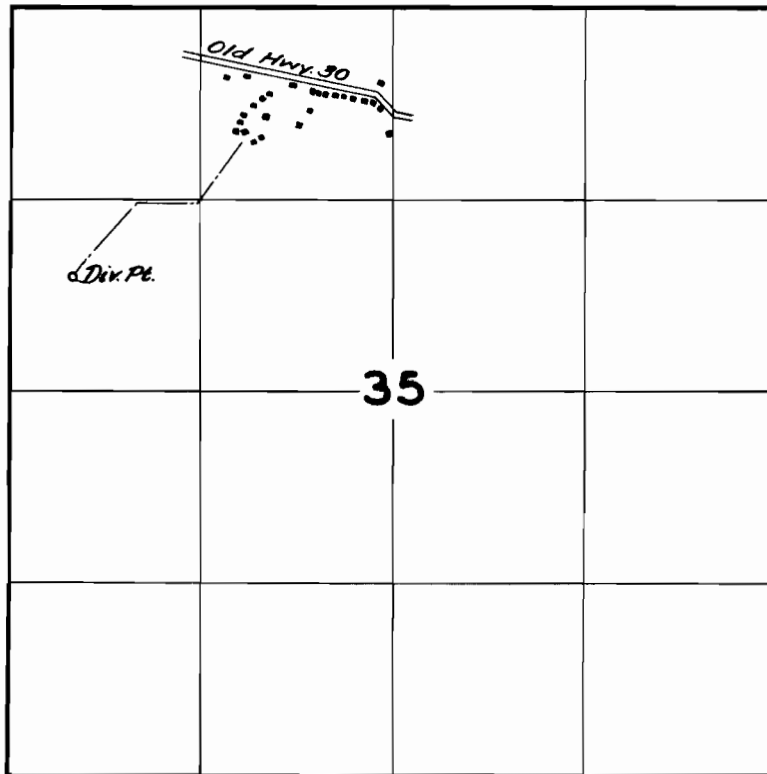

FINAL PROOF SURVEY
UNDER

Application No. 29482 Permit No. 23489
IN NAME OF

James C. & Phyllis J. Cox

Surveyed July 2, 1969 by C. O. Bartels