


T. 3N. R. 2 W. W.M.

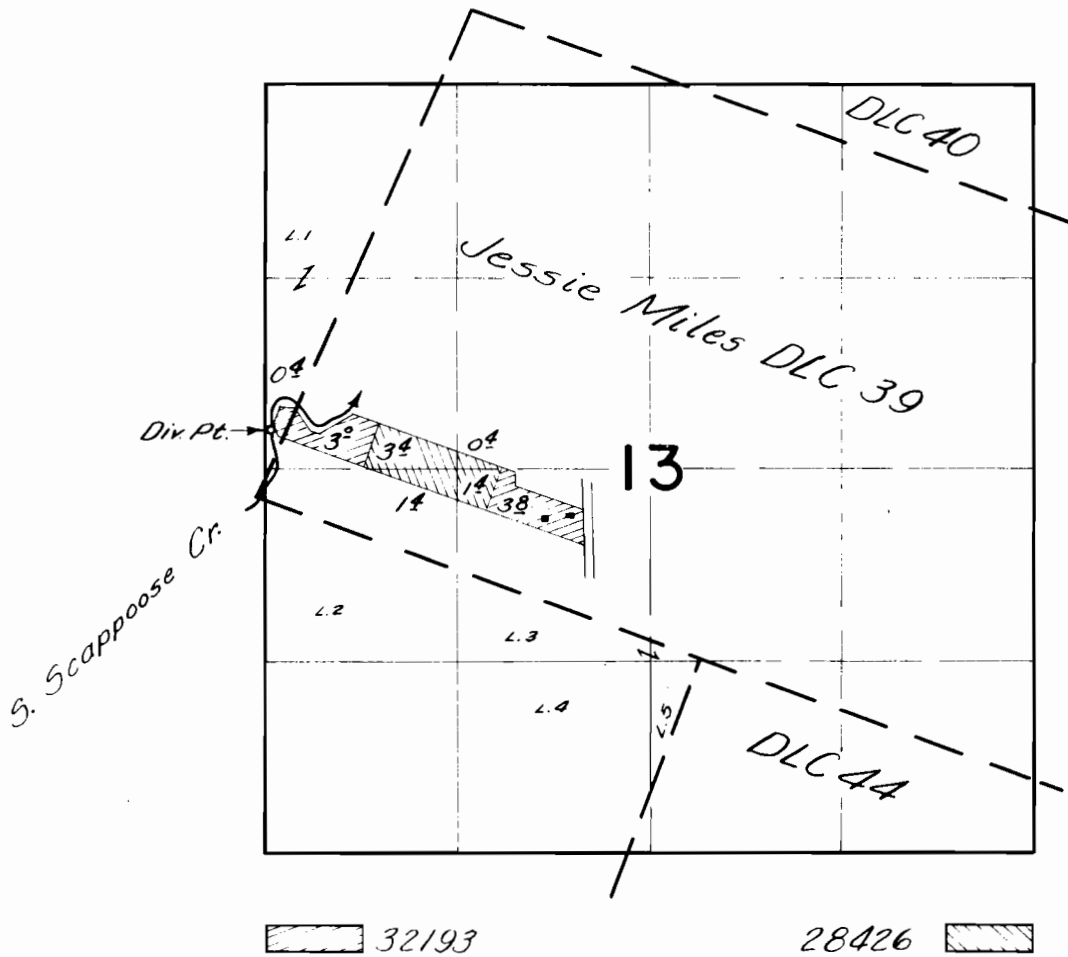

FINAL PROOF SURVEY UNDER

Application No. 28426 Permit No. 22463
32193 25395
IN NAME OF

Charles F. & Mamie M. Sauers

Surveyed July 18 1960, by *C.O. Butts*