


T. 4 N. R. 5 W. W.M.

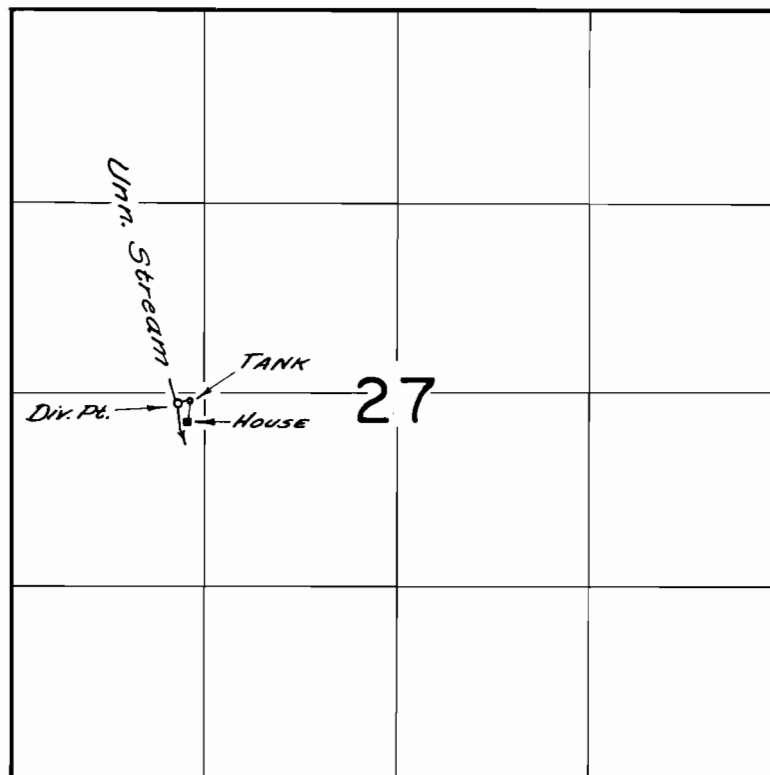

FINAL PROOF SURVEY
UNDER

Application No. 28950 Permit No. 23060
IN NAME OF

PHILLIP LIEBENOW

Surveyed July 20 1960, by C. O. Bartels