


T.4N. R.2W.W.M.

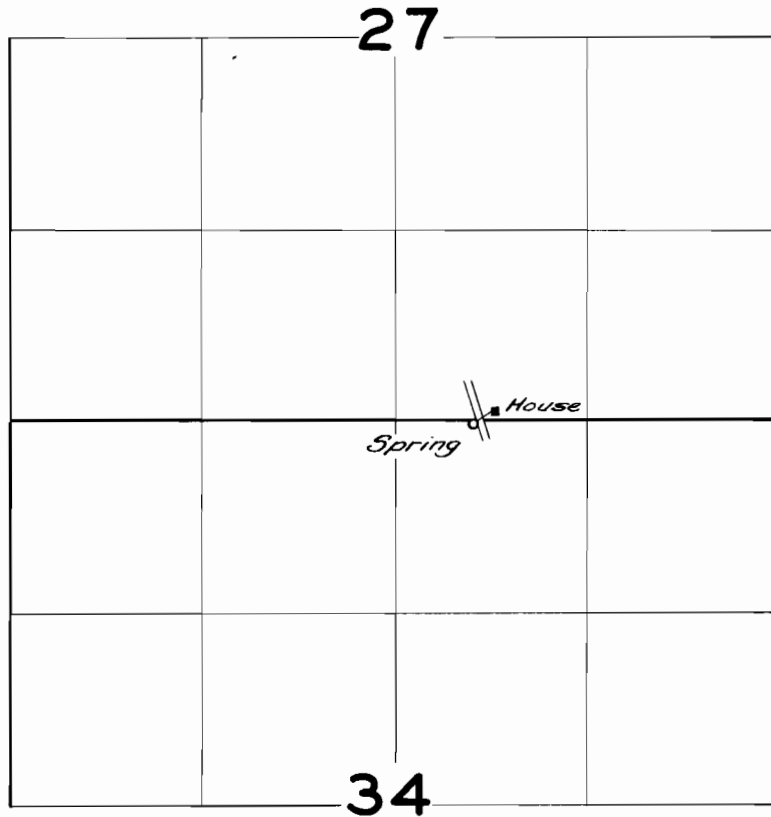

**FINAL PROOF SURVEY**  
UNDER

Application No. *32375* Permit No. *25564*  
IN NAME OF

*Lawrence E. Clark*

Surveyed *July 15* 1960, by *C.D. Bartle*