


T.3N.R.2W.W.M.

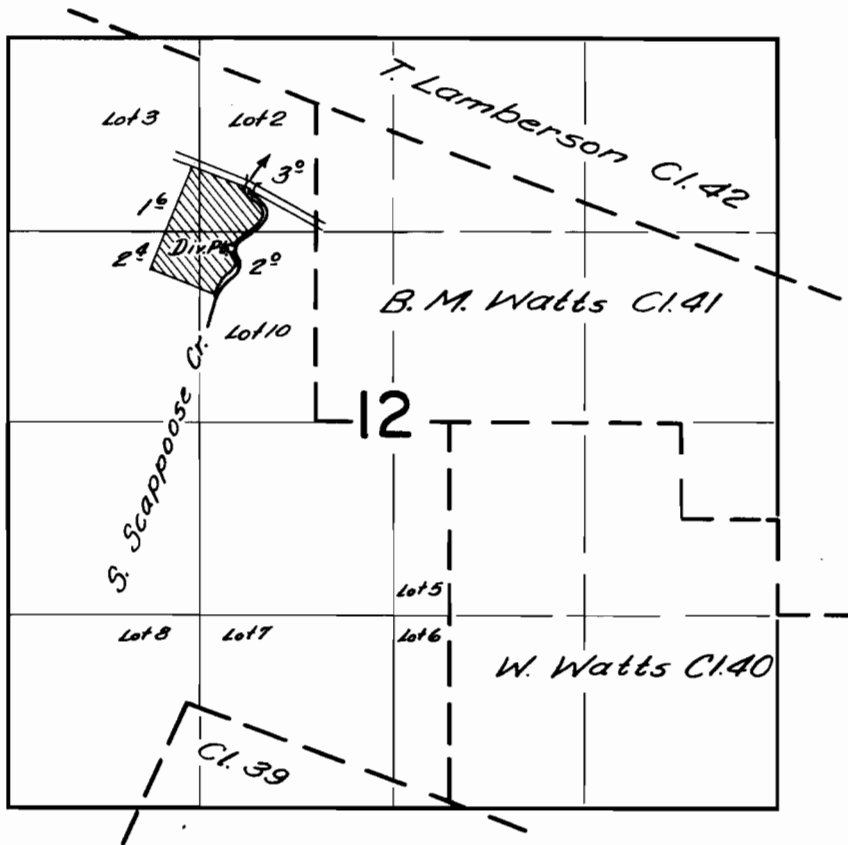

FINAL PROOF SURVEY
UNDER

Application No. 32805 Permit No. 25878
IN NAME OF

ORA & HAZEL JONES

Surveyed July 21, 1960, by C.O. Bartlett