


T. 4 N. R. 1 W. W. M.

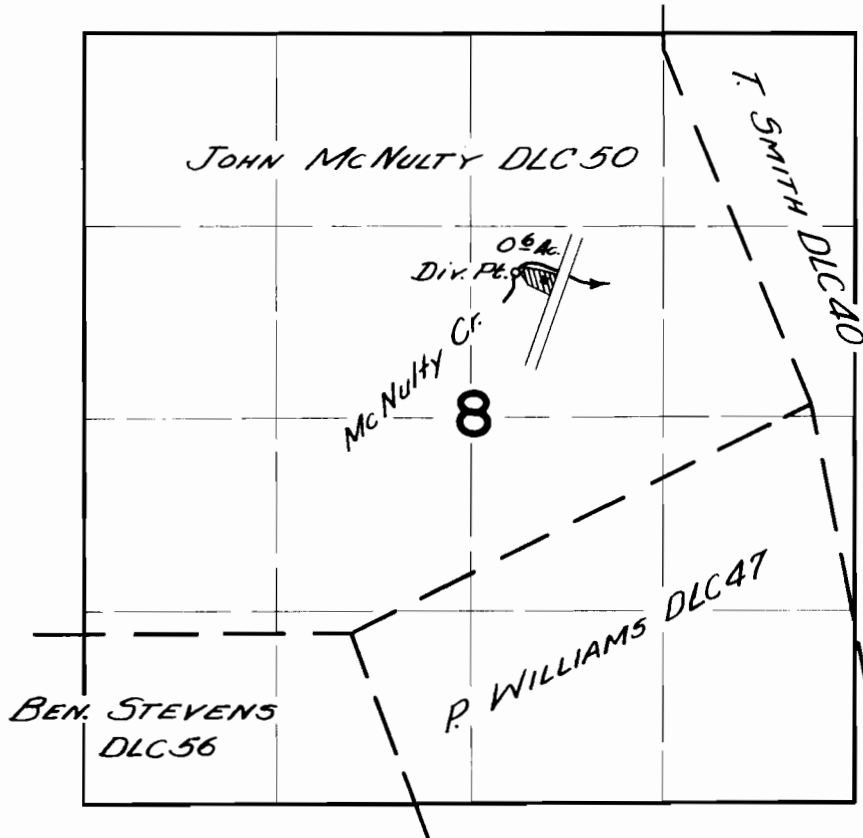

FINAL PROOF SURVEY UNDER

Application No. 24046... Permit No. 25917.....
IN NAME OF

..... *ELMER P. & CORENE E. HALL*

Surveyed July 19... 19.60, by C.O. Bartels.....