


T. 3N. R. 2W. W.M.

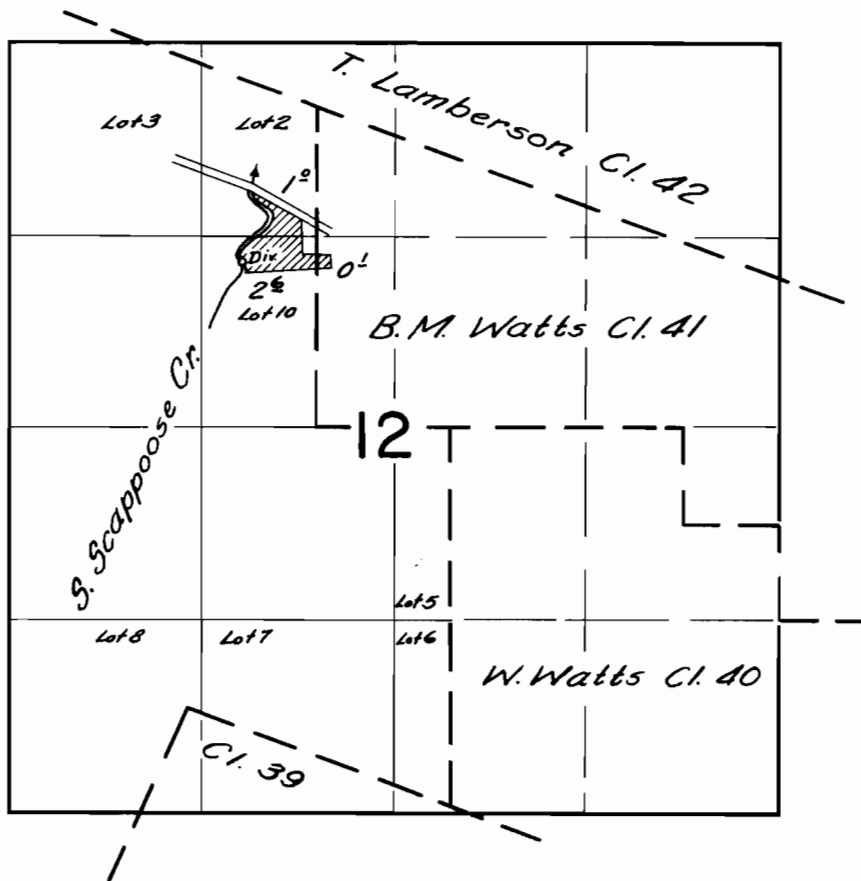

**FINAL PROOF SURVEY**  
UNDER

Application No. 32919..... Permit No. 26017.....  
IN NAME OF

.....*RAY G. HERSTINE*.....

Surveyed *July 21, 1960*, by *C.D. Bartels*