


T. 26 S. R. 14 W. W.M.

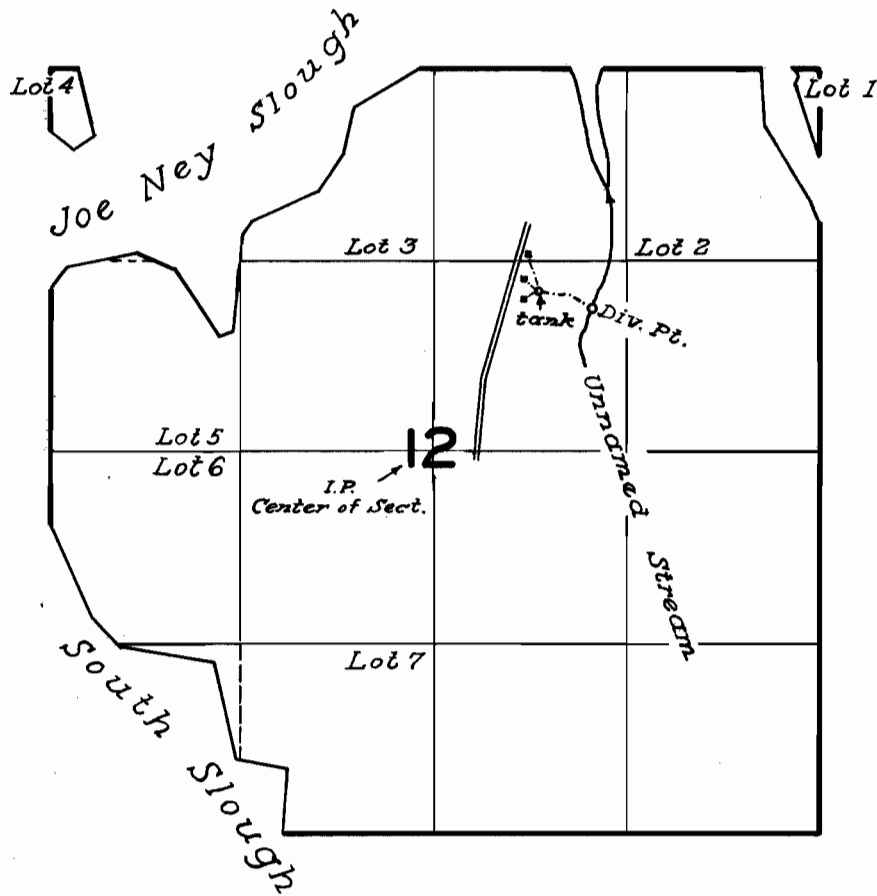

FINAL PROOF SURVEY
UNDER

Application No. 25.218... Permit No. 19.818....
IN NAME OF

BESSIE H. NELSON & BERLIE R. SPENCER

Surveyed June 15, 1960, by *A. Jackson*