


T.30 S. R. II W.W.M.

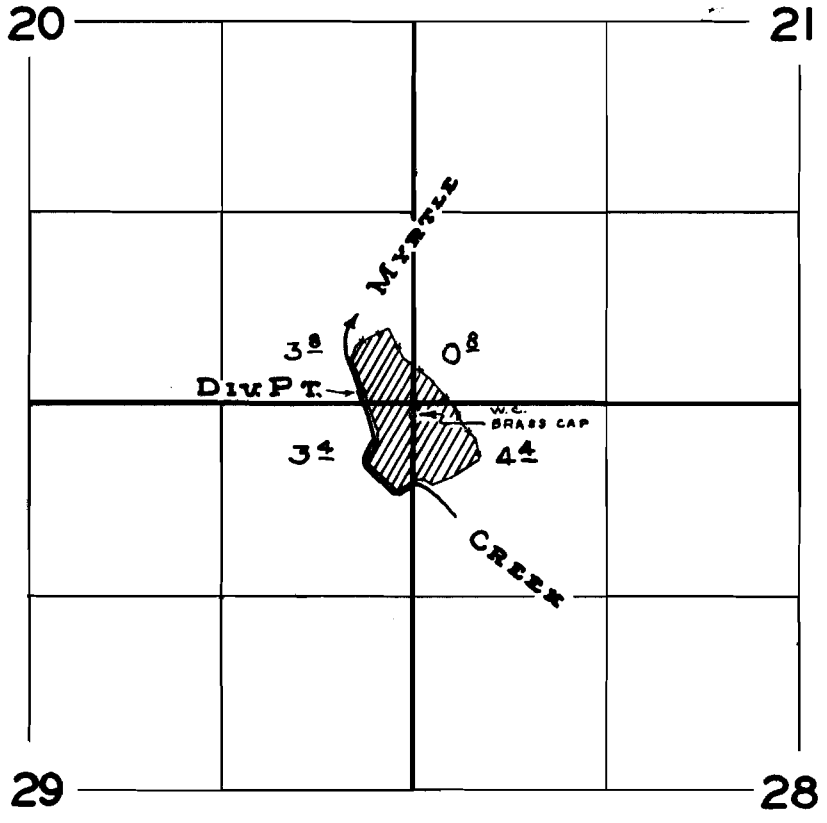

**FINAL PROOF SURVEY**  
UNDER

Application No. 27398. Permit No. 21563....  
IN NAME OF

.....**JAMES E. JEWETT**.....

Surveyed **JUNE 9 1960**, by **M. BISH**.....

*MB.*