


T.28 S. R.14 W.W.M.

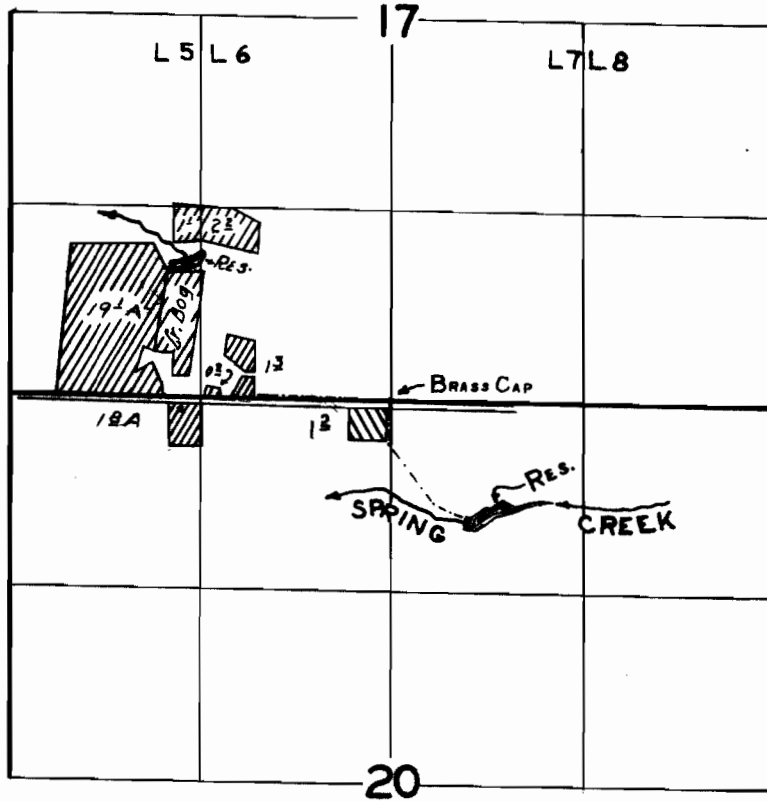

**FINAL PROOF SURVEY**

UNDER  
SUPPLEMENTAL   
PRIMARY 

Application No. R-33076 33076 Permit No. R-2240 26157  
IN NAME OF

W.W. SHERERTZ & R.J. WINTERS

Surveyed JUNE 14 1960, by M. BISH