


T.28S. R.10W.W.M.

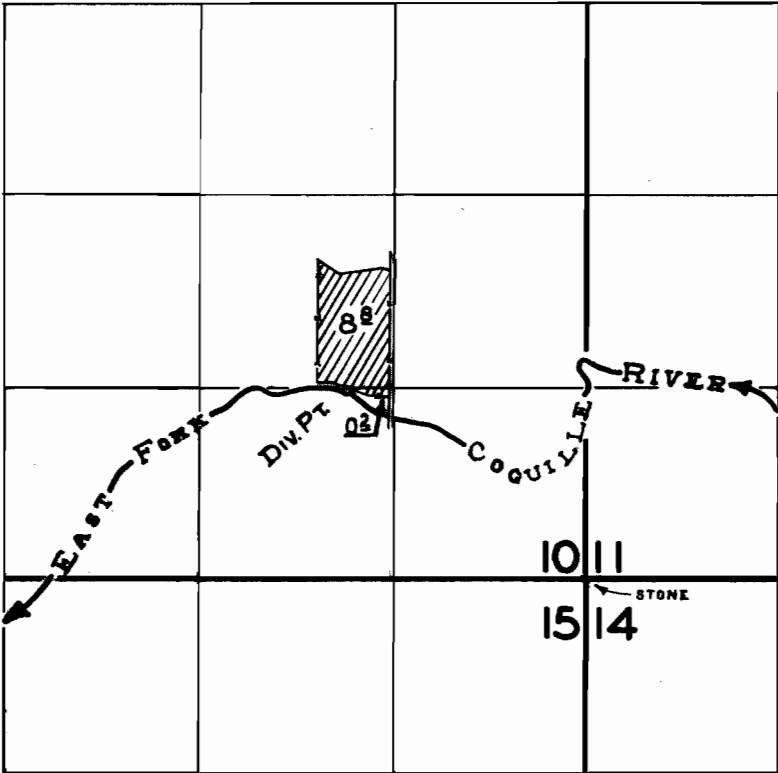

FINAL PROOF SURVEY
UNDER

Application No. 33267 Permit No. 26318
IN NAME OF

.....**THOMAS E. STRODE**.....

Surveyed **JUNE 10 1960**, by *M. BISH*.....