


T.29S. R.8W. W.M.

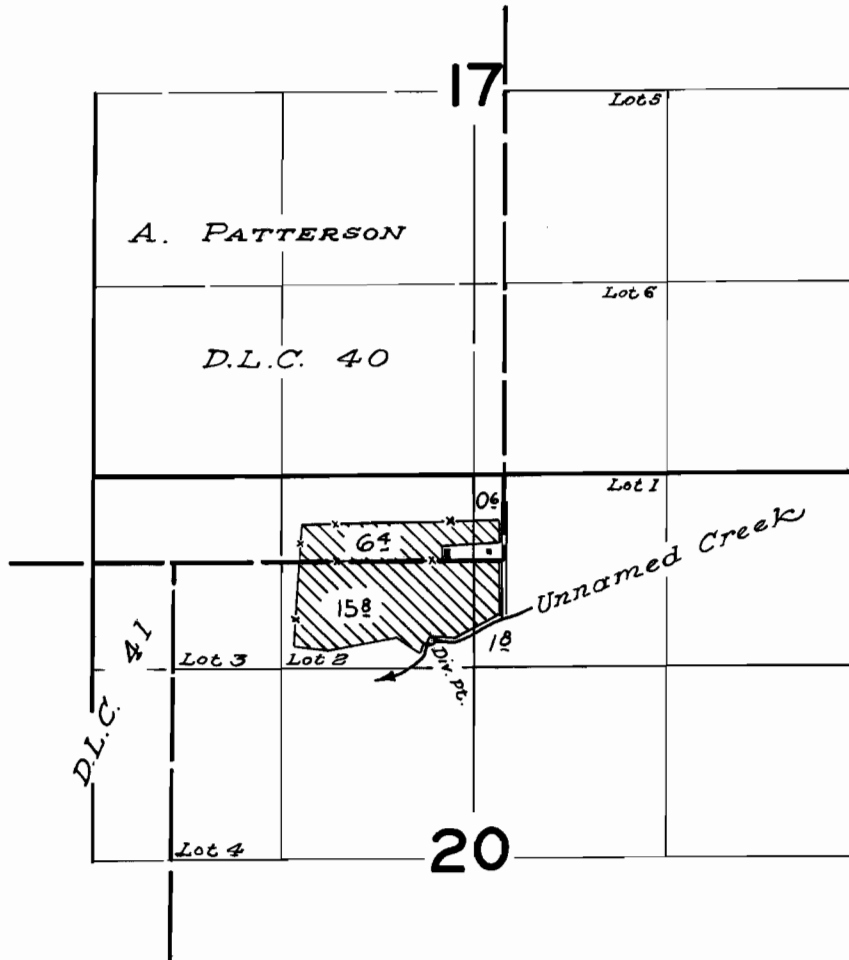

**FINAL PROOF SURVEY**  
UNDER

Application No. 27764 Permit No. 21948...  
IN NAME OF

**M. A. JONES**

Surveyed June 29 1960, by *A. Jackson*