


T.28S. R.6&7 W.W.M:

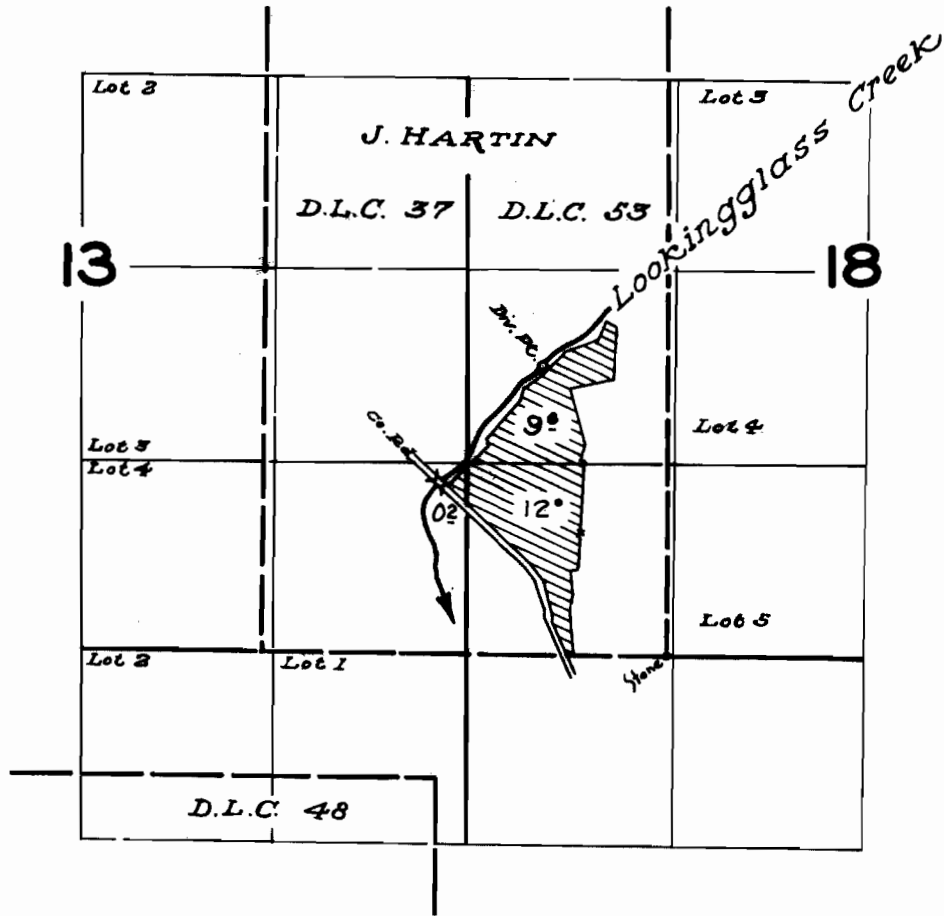

FINAL PROOF SURVEY
UNDER

Application No. 29677. Permit No. 23371...
IN NAME OF

DALE ZELLER

Surveyed June 30 1960., by *[Signature]*