


T. 27S. R. 6W. W.M.

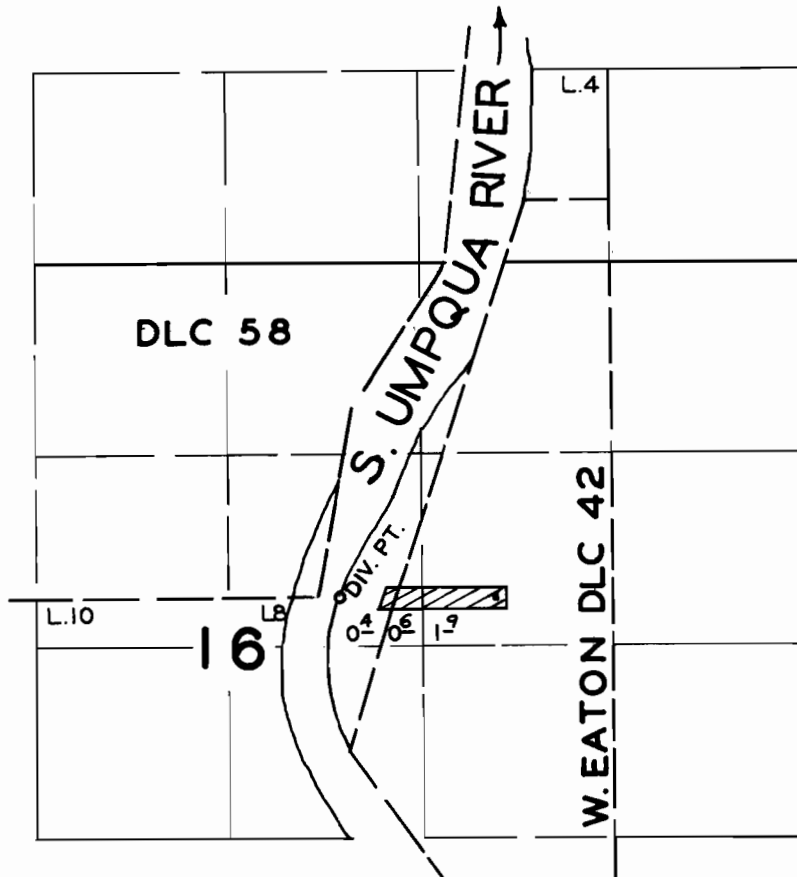

FINAL PROOF SURVEY
UNDER

Application No. 29660 Permit No. 23498
IN NAME OF

ELMER H. & INEZ HITCHMAN

Surveyed AUG. 29, 1960, by C. O. BARTELS