


T.29S.R.8W.W.M.

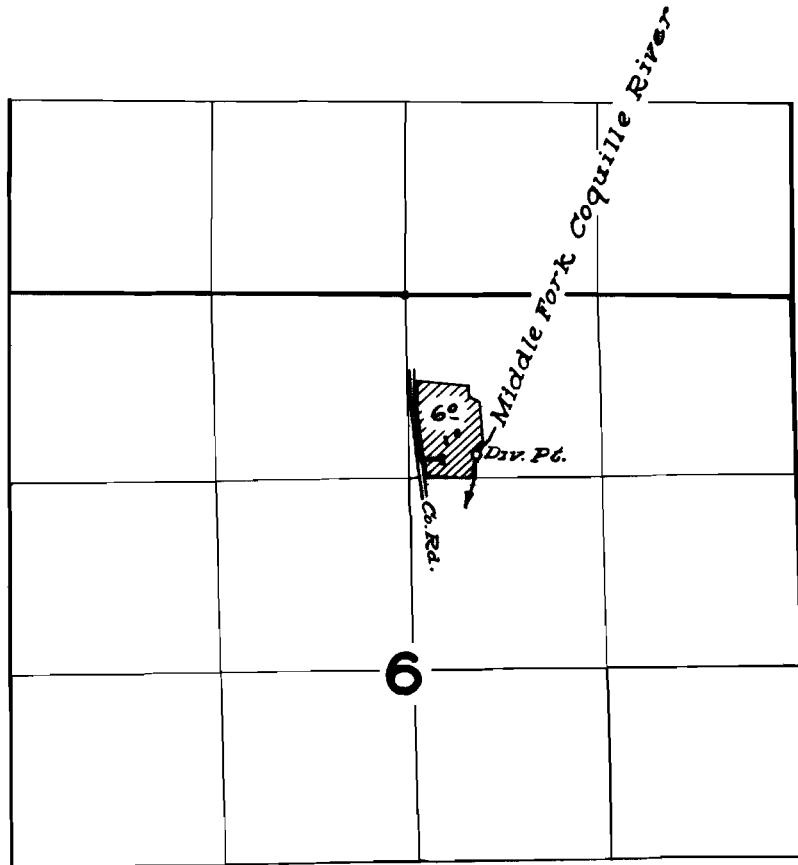

**FINAL PROOF SURVEY**  
UNDER

Application No. 30389.. Permit No. 239.77...  
IN NAME OF

ROY A. THURSTON

Surveyed June 29 1960, by R. Jackson