


T.27 S.R.7 W.W.M.

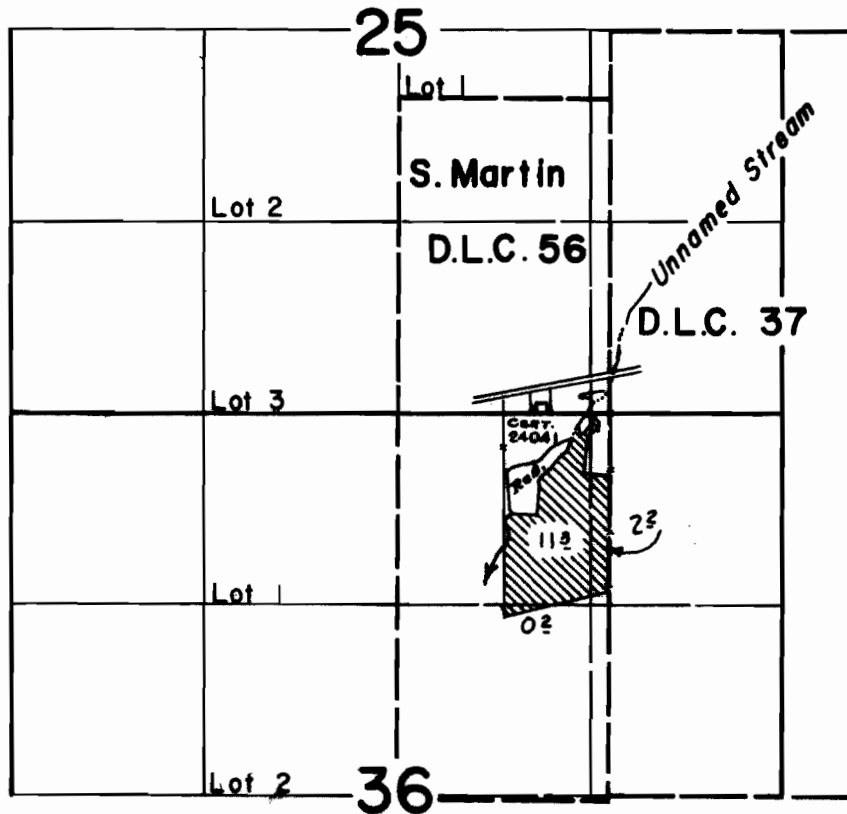

FINAL PROOF SURVEY UNDER

R-30198 R-1844
Application No. 30199..... Permit No. 24105.....
IN NAME OF

.....**Thomas H. Hubbard**.....

Surveyed June 30, 1960, by *R.H. Jackson*