


T.28S. R.6&7 W.W.M.

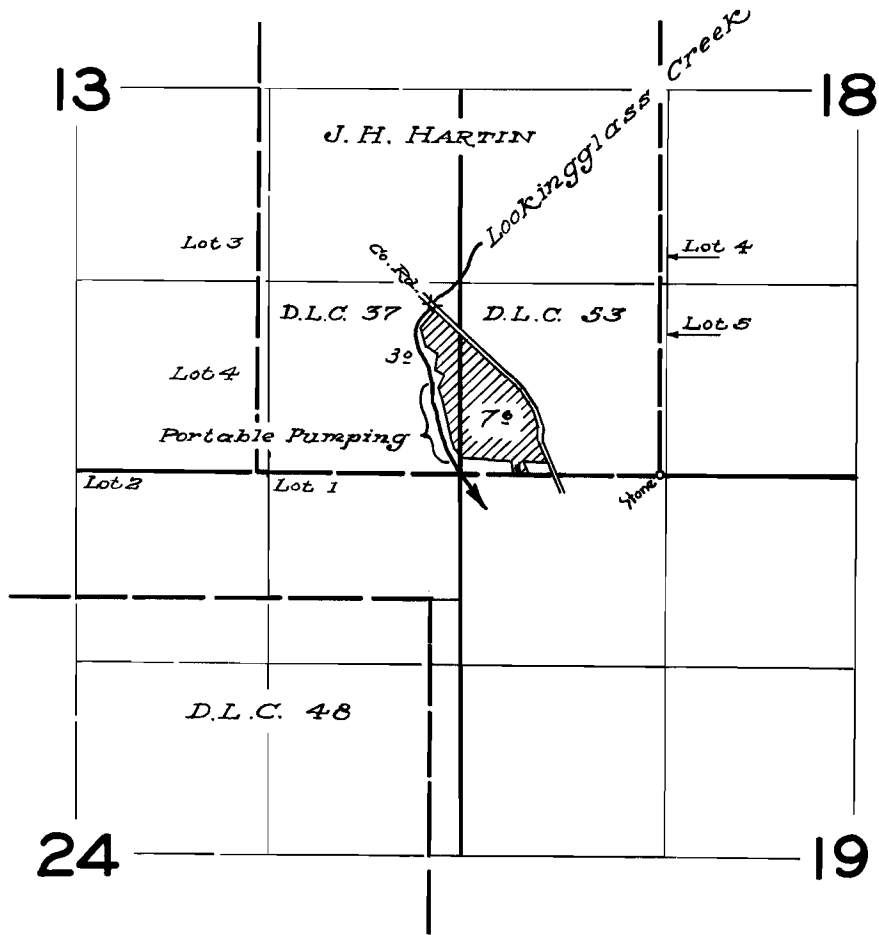

FINAL PROOF SURVEY
UNDER

Application No. 31489... Permit No. 24823...
IN NAME OF

EARL A. BARBER

Surveyed June 30, 1960, by *R. Jackson*