


T.28S.R.7W.W.M.

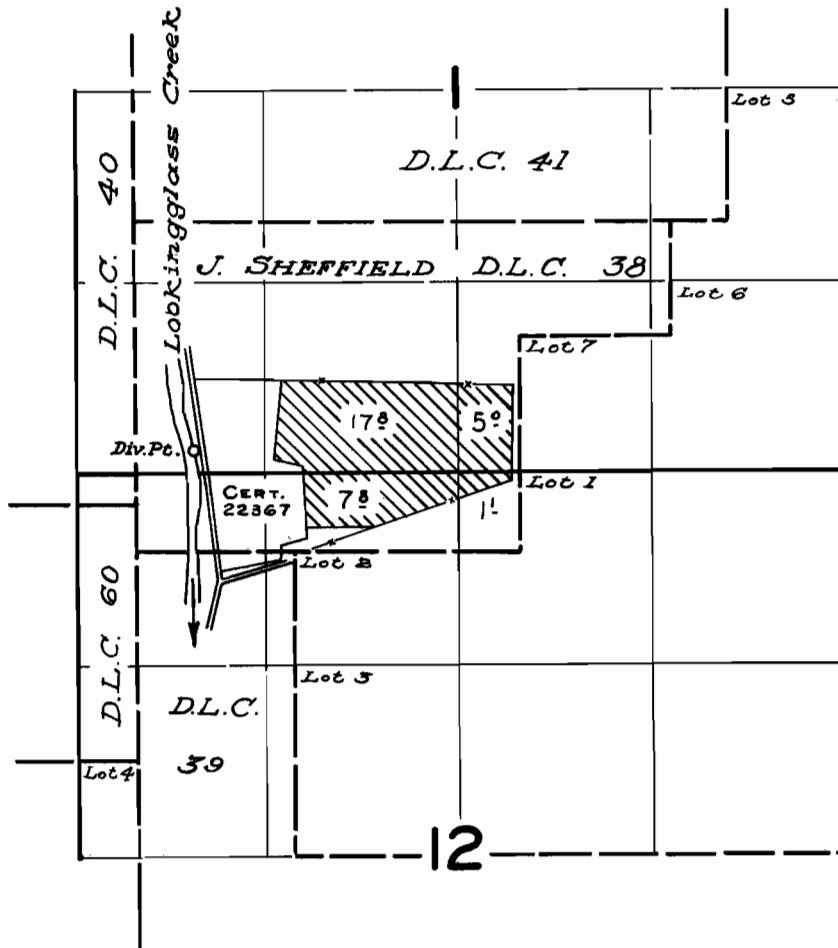

FINAL PROOF SURVEY UNDER

Application No. 32886... Permit No. 25969..
IN NAME OF

..... Ray Wittrock

Surveyed July 1, 1960, by *RH Jackson*