


T. 38S. R. 2W.W.M.

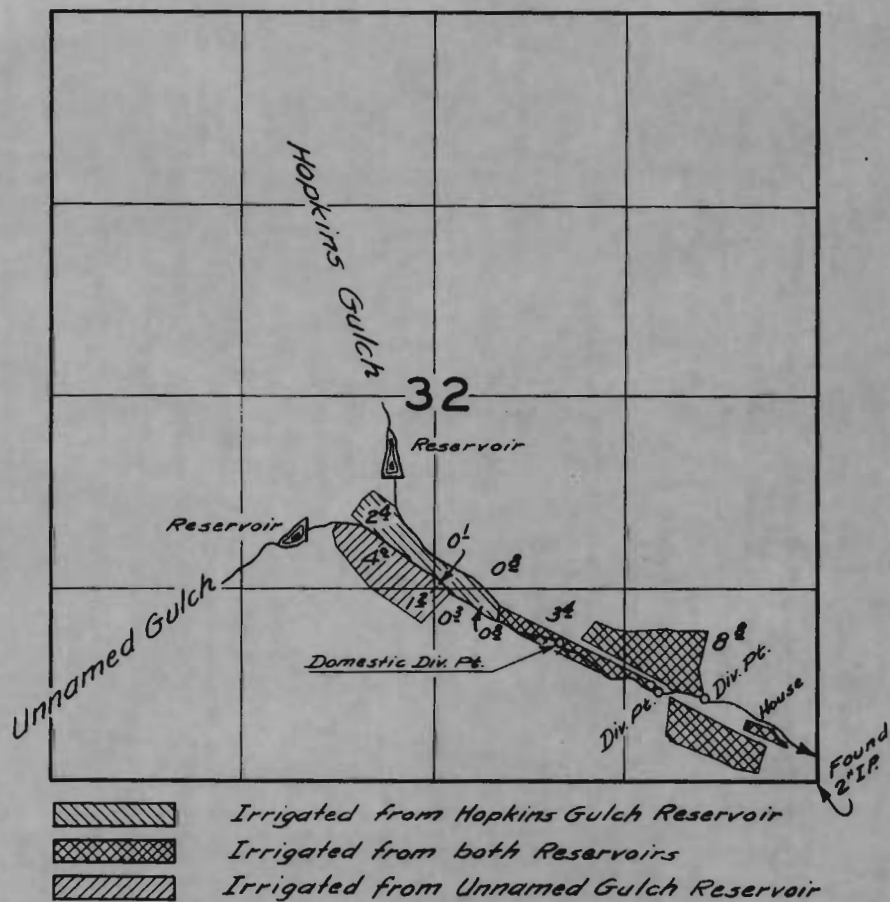

**FINAL PROOF SURVEY**  
UNDER

Application No. <sup>R-24784</sup> 24785 Permit No. <sup>R-1058</sup> 19669  
IN NAME OF

*Albert Nelson*

Surveyed April 14, 1960, by *C.O. Bartels*